

# MISSISSIPPI DEPARTMENT OF NATURAL RESOURCES

Bureau of Land and Water Resources

P.O. Box 10631

Jackson, Mississippi 39209

## WATER WELL DRILLERS LOG

COUNTY WELL LOCATED <b>TATE</b>		
WELL NUMBER <b>D 2084</b>	CODED	PERMIT NUMBER
NAME OF DRILLING FIRM <b>HICKS well CO</b>		
DATE WELL COMPLETED <b>7-14-86</b>		
LOCATION <b>SENATOBID, MS</b>		

NAME & MAILING ADDRESS OF LANDOWNER <b>Robert woods</b>		
<b>RT-4 BOX 286</b>		
<b>Coldwater - MS</b>		
WELL LOCATION: SEC	TOWNSHIP	RANGE
<b>20</b>	<b>#</b>	<b>N S 5</b> (W)
DISTANCE	DIRECTION	NEAREST TOWN
<b>3</b> Miles	<b>N/E</b>	of <b>Bett</b>
OTHER LANDMARK		
WELL PURPOSE (Circle one): Home, Irrigation, Municipal, Industrial, Fish Pond, etc.		


PUMP DATA		
PUMP TYPE (Circle One): <u>Submersible</u> Turbine, Jet, Flowing Well, Other (Describe) _____		
POWER TYPE (Circle One): Electric, Tractor, Diesel, Gasoline, Butane, Other (Describe) _____		
Pump Capacity (GPM) <b>10</b>	No. of Stages <b>7</b>	Setting Depth <b>100</b> FT.
PUMP TEST		
Well yielded <b>10</b> GPM with a drawdown of _____ ft. after _____ hours of pumping		

WELL DATA		
Well Depth <b>155</b>	Casing Diameter (In.) <b>4"</b>	Casing Length (Ft.) <b>145</b>
Type of Casing <b>PVC</b>	Hole Depth <b>155</b>	Depth to Static Water Level <b>80</b>
TYPE OF COMPLETION: (Circle One or More): <u>Gravel Packed</u> , Underreamed, Telescoped, Natural Development, Open Hole, Other		
Top of Lap Pipe or Reduction in Casing		
FEET	IF TELESKOPED OR MORE THAN ONE SCREEN: USE BACK PAGE	

LOG DATA	
TYPE OF LOG RUN (Circle One): No Log Run, Electric, Gamma Ray, Density, Sonic, Neutron, Other (Describe) _____	
Name of Organization Running Log	


SCREEN DATA		
Diameter - Inches <b>4"</b>	Length - Feet <b>10'</b>	Slot Size - Inches <b>013</b>
Screen Type <b>SIOT PVC</b>	Depth to Bottom - Feet <b>10</b>	

GEOLOGIC DATA (Office Use Only)			
Surface Elev.	Geologic Unit	Unit Thickness	Depth to Top
Subs. SWL	Date	Analysis	Aquifer Test
Driller's Remarks			

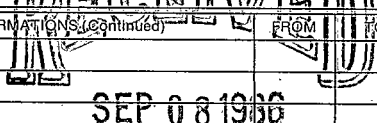DESCRIPTION OF FORMATIONS ENCOUNTERED	FROM	TO	FORMATIONS (continued)	
			FROM	TO
<b>RC</b>	<b>0</b>	<b>20</b>		
<b>WS - C</b>	<b>20</b>	<b>80</b>		
<b>WS.</b>	<b>80</b>	<b>155</b>		
				
			<b>Department of Natural Resources</b>	<b>Resources</b>
			<b>Bureau of Land &amp; Water Resources</b>	<b>Resources</b>
IF MORE SPACE IS NEEDED, USE BACK				

If well telescopes please  
sketch and show depths.

GROUND LEVEL

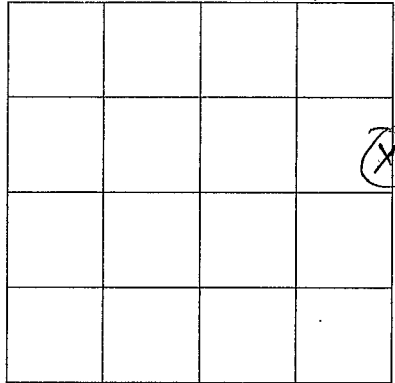

SECTION \_\_\_\_\_

Please indicate well location X.

ADDITIONAL INFORMATION

If more than one screen,  
show location of each on sketch.