

MISSISSIPPI DEPARTMENT OF NATURAL RESOURCES
Bureau of Land and Water Resources

P.O. Box 10631
Jackson, Mississippi 39209
WATER WELL DRILLERS LOG

COUNTY WELL LOCATED TATE	
WELL NUMBER D	CODED
2094	
DATE WELL COMPLETED 6-10-88	

PERMIT NUMBER HICKS WELL COMPANY
NAME OF DRILLING FIRM RT. 1 - BOX 137
SENATOBIA, MISS.

NAME & MAILING ADDRESS OF LANDOWNER Mabel Light
Independence
MS.
WELL LOCATION: SEC _____ TOWNSHIP _____ RANGE _____ 30 N 5 E
DISTANCE _____ MILES _____ DIRECTION _____ NEAREST TOWN _____ 1/2 N of BETT
OTHER LANDMARK CLOST TO CO. LINE RD
WELL PURPOSE: Home, Irrigation, Municipal, Industrial, Fish Pond, etc.

PUMP DATA		
PUMP TYPE (Circle One): <u>Submersible</u> Turbine, Jet, Flowing Well, Other (Describe) _____		
POWER TYPE (Circle One): Electric, Tractor, Diesel, Gasoline, Butane, Other (Describe) _____		
Pump Capacity (GPM) 10	No. of Stages 9	Setting Depth 90 FT.
PUMP TEST Well yielded 10 GPM with a drawdown of _____ ft. after _____ hours of pumping		

WELL DATA		
Well Depth 140	Casing Diameter (In.) 4"	Casing Length (Ft.) 130
Type of Casing PVC	Hole Depth 6"	Depth to Static Water Level 80
TYPE OF COMPLETION: (Circle One or More): <u>Gravel Packed</u> , Underreamed, Telescoped, Natural Development, Open Hole, Other (Describe) _____		
Top of Lap Pipe or Reduction in Casing FEET _____ IF TELESCOPED OR MORE THAN ONE SCREEN: USE BACK PAGE		

LOG DATA	
TYPE OF LOG RUN (Circle One): No Log Run, Electric, Gamma Ray, Density, Sonic, Neutron, Other (Describe) _____	
Name of Organization Running Log _____	

SCREEN DATA		
Diameter - Inches 4"	Length - Feet 10'	Slot Size - Inches 0/3
Screen Type PVC	Depth to Bottom - Feet 10'	


GEOLOGIC DATA (Office Use Only)			
Surface Elev.	Geologic Unit	Unit Thickness	Depth to Top
Subs. SWL	Date	Analysis	Aquifer Test
Driller's Remarks			

DESCRIPTION OF FORMATIONS ENCOUNTERED	FROM	TO	FORMATIONS (Continued)	FROM	TO
Red. clay	0	15	RECEIVED		
SMALL GRAVEL - S.	15	50			
W. S.	50	140			
			JUN 28 1988		
			Department of Natural Resources Bureau of Land & Water Resources		

IF MORE SPACE IS NEEDED, USE BACK

If well telescopes please
sketch and show depths.

GROUND LEVEL

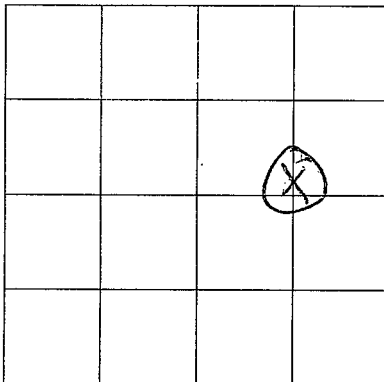

SECTION _____

Please indicate well location X.

ADDITIONAL INFORMATION

If more than one screen,
show location of each on sketch.