

MISSISSIPPI DEPARTMENT OF ENVIRONMENTAL QUALITY

Office of Land and Water Resources

COUNTY WELL LOCATED
Tate

WELL NUMBER
D

DATE WELL COMPLETED
2100
9-28-94

PERMIT NUMBER
HICKS WELL CO.

NAME OF DRILLING FIRM
RTM BOX 157
SENATOBIA, MS 38668

P. O. Box 10631
Jackson, MS 39289-0631
WATER WELL DRILLERS LOG

NAME & MAILING ADDRESS OF LANDOWNER
SWAIN Gardner
Rt 4 Box 350 AA
Coldwater, ms

WELL LOCATION: SEC 19 TOWNSHIP 4 N RANGE 5 E

DISTANCE 10 Miles NE of Senatobia ms

OTHER LANDMARK

WELL PURPOSE (Home) Irrigation, Municipal, Industrial, Fish Pond, etc.

PUMP DATA

PUMP TYPE (Circle One):
Submersible, Turbine, Jet, Flowing Well,
Other (Describe) _____

POWER TYPE (Circle One):
Electric, Tractor, Diesel, Gasoline, Butane,
Other (Describe) _____ H/P 1/2

Pump Capacity (GPM) 10 No. of Stages 6BC Setting Depth 120 FT.

PUMP TEST

Well yielded _____ GPM with
a drawdown of _____ ft.
after _____ hours of pumping

WELL DATA

Well Depth <u>160'</u>	Casing Diameter (In.) <u>4"</u>	Casing Length (Ft.) <u>150'</u>
Type of Casing <u>PVC</u>	Hole Depth <u>160'</u>	Depth to Static Water Level <u>80'</u>

TYPE OF COMPLETION: (Circle One or More):
Gravel Packed, Underreamed, Telescoped,
Natural Development, Open Hole, Other
(Describe) _____

WELL GROUTED TO A DEPTH OF 3 FEET
Type Grout (circle one): Cement, Bentonite, or Mix

LOG DATA

TYPE OF LOG RUN (Circle One):
No Log Run, Electric, Gamma Ray, Density, Sonic, Neutron,
Other (Describe) _____

Name of Organization Running Log

SCREEN DATA

Diameter - inches <u>4"</u>	Length - Feet <u>10'</u>	Slot Size - Inches <u>.013</u>
Screen Type <u>PVC</u>	Depth to Bottom - Feet <u>160'</u>	


GEOLOGIC DATA (Office Use Only)

Surface Elev.	Geologic Unit	Unit Thickness	Depth to Top
Subs. SWL	Date	Analysis	Aquifer Test

Driller's Remarks

Top of Lap Pipe or Reduction in Casing

FEET IF TELESKOPED OR MORE THAN ONE SCREEN: USE BACK PAGE

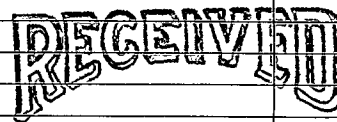
DESCRIPTION OF FORMATIONS ENCOUNTERED	FROM	TO	FORMATIONS (Continued)	FROM	TO
<u>Red Sand</u>	<u>0</u>	<u>40</u>	 DEC 21 1994		
<u>SAND & CLAY</u>	<u>40</u>	<u>80</u>			
<u>White Sand</u>	<u>80</u>	<u>160</u>			

Dept. of Environmental Quality
Office of Land & Water Resources

IF MORE SPACE IS NEEDED, USE BACK

If well telescopes please sketch and show depths.

GROUND LEVEL

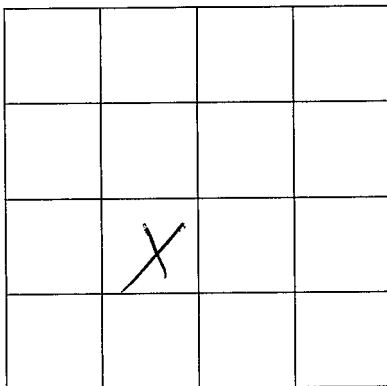

SECTION 19

Please indicate well location X.

ADDITIONAL INFORMATION

If more than one screen,
show location of each on sketch.