

MISSISSIPPI DEPARTMENT OF ENVIRONMENTAL QUALITY

Office of Land and Water Resources

P. O. Box 10631
Jackson, MS 39289-0631
WATER WELL DRILLERS LOG

COUNTY WELL LOCATED TATE	
WELL NUMBER D2114	CODED
DATE WELL COMPLETED 10-12-99	

PERMIT NUMBER HICKS WELL CO.
NAME OF DRILLING FIRM
SEYMOURIA, MS 39088

NAME & MAILING ADDRESS OF LANDOWNER FARROW MANOR BAPTIST CHILDRENS VILLAGE P.O. Box 27		
JACKSON, MS 39060-0027		
WELL LOCATION: SEC	TOWNSHIP	RANGE
32	4	N 5 E
DISTANCE	DIRECTION	NEAREST TOWN
1/2 Miles	NE	Beth
OTHER LANDMARK South well		
WELL PURPOSE: Home, Irrigation, Municipal, Industrial, Fish Pond, etc.		

PUMP DATA			
PUMP TYPE (Circle One): <input checked="" type="radio"/> Submersible, Turbine, Jet, Flowing Well, Other (Describe) _____			
POWER TYPE (Circle One): <input checked="" type="radio"/> Electric, Tractor, Diesel, Gasoline, Butane, Other (Describe) _____ H/P 1/2			
Pump Capacity (GPM)	No. of Stages	Setting Depth	
20		100 FT.	
PUMP TEST			
Well yielded no GPM with a drawdown of 1/2 ft. after _____ hours of pumping			

WELL DATA		
Well Depth 137	Casing Diameter (In.) 4	Casing Length (Ft.) 117
Type of Casing PVC	Hole Depth 137	Depth to Static Water Level 70
TYPE OF COMPLETION: (Circle One or More): <input checked="" type="radio"/> Gravel Packed, Underreamed, Telescoped, Natural Development, Open Hole, Other (Describe) _____		
WELL GROUTED TO A DEPTH OF 3 FEET Type Grout (circle one): Cement, <input checked="" type="radio"/> Bentonite, or Mix		

LOG DATA	
TYPE OF LOG RUN (Circle One): <input checked="" type="radio"/> No Log Run, Electric, Gamma Ray, Density, Sonic, Neutron, Other (Describe) _____	
Name of Organization Running Log	

SCREEN DATA		
Diameter - Inches 4	Length - Feet 20	Slot Size - Inches .014
Screen Type PVC slot	Depth to Bottom - Feet 117	


GEOLOGIC DATA (Office Use Only)			
Surface Elev.	Geologic Unit	Unit Thickness	Depth to Top
Subs. SWL	Date	Analysis	Aquifer Test
Driller's Remarks RECEIVED Top of Lap Pipe or Reduction in Casing FEET <input checked="" type="checkbox"/> IF TELESCOPED OR MORE THAN ONE SCREEN, USE BACK PAGE			

DESCRIPTION OF FORMATIONS ENCOUNTERED	FROM	TO
Red + white clay	0	15
Red + white clay	15	45
Sand		
white Sand + clay	45	85
white Sand	85	137

FORMATIONS (Continued)	FROM	TO
Dept. of Environmental Quality Office of Land & Water Resources		
IF MORE SPACE IS NEEDED, USE BACK		

If well telescopes please sketch and show depths.

GROUND LEVEL

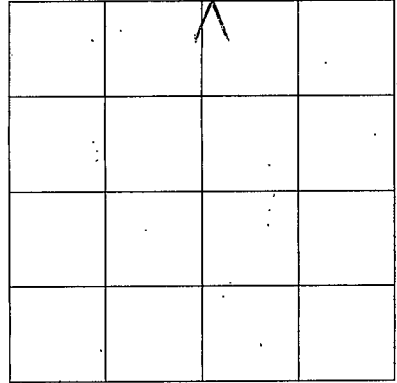

SECTION 32

Please indicate well location X.

ADDITIONAL INFORMATION

If more than one screen,
show location of each on sketch.