

MISSISSIPPI DEPARTMENT OF ENVIRONMENTAL QUALITY
Office of Land and Water Resources

P. O. Box 10631
Jackson, MS 39289-0631
WATER WELL DRILLERS LOG

COUNTY WELL LOCATED <u>LATE</u>	
WELL NUMBER <u>194</u>	CODED
D-2118	
DATE WELL COMPLETED <u>3-18-00</u>	

PERMIT NUMBER
NAME OF DRILLING FIRM <u>SMITH Well</u>
<u>DRILLING SERV.</u>

NAME & MAILING ADDRESS OF LANDOWNER <u>Anderson + Sisk</u>			
<u>FRANK PLACE</u>			
<u>INDEPENDENCE</u>			
WELL LOCATION	SEC	TOWNSHIP	RANGE
<u>E</u>	<u>T-4</u>	<u>S</u>	<u>R-5</u>
DISTANCE <u>3</u> Miles	DIRECTION <u>E</u>	NEAREST TOWN <u>INDEPENDENCE</u>	
OTHER LANDMARK			
WELL PURPOSE Home, Irrigation, Municipal, Industrial, Fish Pond, etc. <u>HOME</u>			

PUMP DATA		
PUMP TYPE (Circle One): <u>Submersible</u> Turbine, Jet, Flowing Well, Other (Describe) _____		
POWER TYPE (Circle One): <u>Electric</u> , Tractor, Diesel, Gasoline, Butane, Other (Describe) _____ H/P <u>12</u>		
Pump Capacity (GPM) <u>12</u>	No of Stages <u>9</u>	Setting Depth <u>80</u> FT.
PUMP TEST		
Well yielded <u>15</u> GPM with a drawdown of <u>1</u> ft. after <u>1</u> hours of pumping		

WELL DATA		
Well Depth <u>116</u>	Casing Diameter (in) <u>4"</u>	Casing Length (Ft.) <u>186</u>
Type of Casing <u>PVC</u>	Hole Depth <u>116</u>	Depth to Static Water Level <u>50</u>
TYPE OF COMPLETION: (Circle One or More): Gravel Packed, Underreamed, Telescoped, Natural Development, Open Hole, Other (Describe) <u>WASHED SAND</u>		
WELL GROUTED TO A DEPTH OF <u>10</u> FEET Type Grout (circle one): Cement, Bentonite, or Mix		

LOG DATA	
TYPE OF LOG RUN: (Circle One): <u>Electric</u> , Gamma Ray, Density, Sonic, Neutron, Other (Describe) _____ No Log Run	
Name of Organization Running Log	

SCREEN DATA		
Diameter - Inches <u>4"</u>	Length - Feet <u>10</u>	Slot Size - Inches <u>1/4 THOUS.</u>
Screen Type <u>PVC</u>	Depth to Bottom - Feet <u>116</u>	


GEOLOGIC DATA (Office Use Only)			
Surface Elev	Geologic Unit	Unit Thickness	Depth to Top
Subs. SWL	Date	Analysis	Aquifer Test
Driller's Remarks			
RECEIVED			
Top of Log Pipe or Reduction in Casing			
FEET			
IF TELESCOPED OR MORE THAN ONE SCREEN: USE BACK PAGE			

DESCRIPTION OF FORMATIONS ENCOUNTERED	FROM	TO
<u>TOP SOIL</u>	<u>0</u>	<u>15</u>
<u>WHITE CLAY & SAND</u>	<u>15</u>	<u>70</u>
<u>WHITE SAND</u>	<u>70</u>	<u>116</u>

FORMATIONS (Continued)		FROM	TO
Dept. of Environmental Quality Office of Land & Water Resources			
IF MORE SPACE IS NEEDED, USE BACK			

If well telescopes please sketch and show depths.

GROUND LEVEL

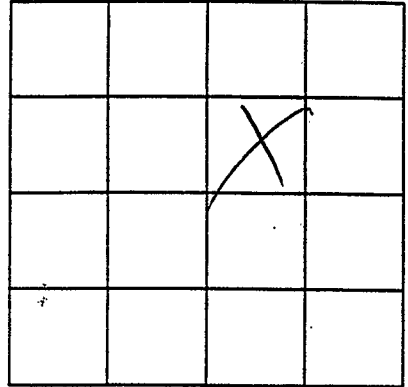

SECTION E-30

Please indicate well location X.

ADDITIONAL INFORMATION

RECEIVED

NOV 19 1968

Office of Range & Water Resources
Dept. of Environmental Quality

If more than one screen,
show location of each on sketch.