

MISSISSIPPI
BOARD OF WATER COMMISSIONERS
416 North State Street
Jackson, Mississippi 39201

CODED

WATER WELL DRILLERS LOG

TATE
E3
4-71

4 date well completed 19 71 Harris Bros. firm name Tate county well located

LANDOWNER: Marvin Ferguson
pt. 1 Lark
(mailing address)

description of formations encountered	from	to
top soil	0	20
sand + red clay	20	45
grey clay	45	90
fine sand + clay	90	165
course sand	165	190

WELL LOCATION:
sec. 34 T-S N R-9 E
2 miles SW of Stacyton
(distance) (direction) (nearest town)

WELL PURPOSE: None
(home, irrigation, municipal, industrial)

- WELL COMPLETION DATA:
- (1) diameter (inches) 4
 - (2) total depth (feet) 190
 - (3) static water level (feet) 80 below top of ground.
 - (4) casing Plastic 176
(material) (depth)
4 if telescope see back.
(size)
 - (5) screen 14 176
(length) (depth to top)
008 Plastic
(size) (material)
 - (6) pump 3/4 10
(HP) (yield gpm)
elec.
(type power)
 - (7) electric log no
(yes or no)

CODED

(organization running log)
(8) how well bottom plugged wash
and


DRILLERS REMARKS:

MAY 14 1971

MISS. BD. OF
WATER COMMISSIONERS

If well telescopes please sketch and show depths.

GROUND LEVEL

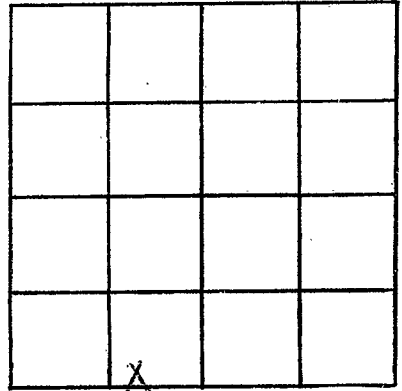

SECTION 34

Please indicate well location X.

ADDITIONAL INFORMATION

Lined area for additional information.

If more than one screen, show locations of each on sketch.