

MISSISSIPPI  
BOARD OF WATER COMMISSIONERS  
416 North State Street  
Jackson, Mississippi 39201

**CODED**

**WATER WELL DRILLERS LOG**

May 30 1971 Shelly Meyman Jate  
date well completed firm name county well located

LANDOWNER: Frank Holloway  
R.F.D.  
Coldwater Miss.  
(mailing address)

description of formations encountered	from	to
<u>Black clay</u>	<u>0</u>	<u>60</u>
<u>white sand</u>	<u>60</u>	<u>62</u>
<u>white clay</u>	<u>62</u>	<u>130</u>
<u>white sand</u>	<u>130</u>	<u>146</u>

WELL LOCATION:  
sec. 18 T. 5 N. R. 9  
3 miles N-E of Savage  
(distance) (direction) (nearest town)

WELL PURPOSE: Home  
(home, irrigation, municipal, industrial)

- WELL COMPLETION DATA:
- (1) diameter (inches) 2
  - (2) total depth (feet) 146
  - (3) static water level (feet) 31 below top of ground.
  - (4) casing Galv. 140  
(material) (depth)  
\_\_\_\_ if telescope see back.  
(size)
  - (5) screen 6 (length) (depth to top)  
1/4 (size) 5x5x (material)
  - (6) pump 1/2 (HP) 4 (yield gpm)  
Electric (type power)
  - (7) electric log no (yes or no)  
JNO (organization running log)
  - (8) how well bottom plugged Rubber Seal

**CODED**


JUN 10 1971

DRILLERS REMARKS:

MISS. BD. OF  
WATER COMM.

If well telescopes please sketch and show depths.

GROUND LEVEL

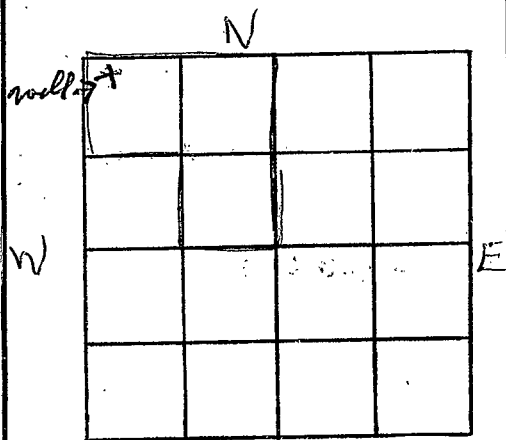

SECTION 18

Please indicate well location X.

ADDITIONAL INFORMATION

If more than one screen,  
show locations of each on sketch.