

2ate  
E7  
9-25-68

MISSISSIPPI  
BOARD OF WATER COMMISSIONERS  
416 North State Street  
Jackson, Mississippi 39201

CODED

WATER WELL DRILLERS LOG

Sept 25 1968 Shelby Neyman Jate  
date well completed firm name county well located

LANDOWNER: Joe Willard  
Sarah Mize  
Rt. 7, D1  
(mailing address)

description of formations encountered	from	to
Red clay	0	30
Red sand & gravel	30	60
grey clay	60	210
Blue sand	210	220
grey clay	220	285
clear white sand	285	302

WELL LOCATION:  
sec. 20 T. 5 N R. 9 E  
3 miles N of Strayhorn  
(distance) (direction) (nearest town)

WELL PURPOSE: Home  
(home, irrigation, municipal, industrial)

WELL COMPLETION DATA:

(1) diameter (inches) 2

(2) total depth (feet) 302

(3) static water level (feet) 70 below top of ground.

(4) casing Galvanneze 296 (material) (depth)  
if telescope see back. (size)

(5) screen 5 ft (length) (depth to top)  
1 1/4 slot, Stainless Steel (size) (material)

(6) pump 3/4 HP (type power) 4 (yield gpm)

(7) electric log no (yes or no)  
(organization running log)

(8) how well bottom plugged Rubber Seal

CODED


OCT 10 1968

MISS. BD. OF  
WATER COMMISSIONERS

DRILLERS REMARKS:

If well telescopes please sketch and show depths.

GROUND LEVEL

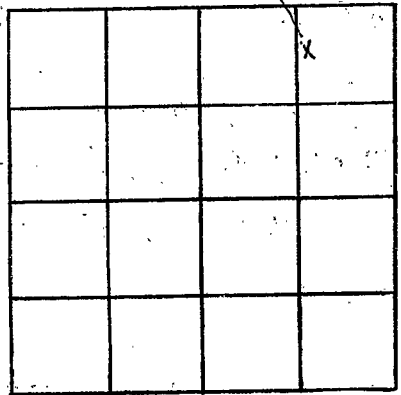

SECTION \_\_\_\_\_

Please indicate well location X.

ADDITIONAL INFORMATION

If more than one screen, show locations of each on sketch.