

CODED

MISSISSIPPI
BOARD OF WATER COMMISSIONERS
416 North State Street
Jackson, Mississippi 39201

WATER WELL DRILLERS LOG

CODED

Zato
ER
10-10-68

10-10 1968 Harris Bros Zato
date well completed firm name county well located

LANDOWNER: Charlie Mack
Rte 2 Box 48
Senatobia
(mailing address)

description of formations encountered	from	to
top soil	0	20
sand	20	40
sand + clay	40	85
gray clay	85	120
sand + clay	120	155
Coarse sand	155	174

WELL LOCATION:
sec. 1 T. 5 N. R. 9 E
9 miles W of Collierville
(distance) (direction) (nearest town)

WELL PURPOSE: Domestic
(home, irrigation, municipal, industrial)

- WELL COMPLETION DATA:
- (1) diameter (inches) 4"
 - (2) total depth (feet) 174
 - (3) static water level (feet) 100 ^{below} above top of ground.
 - (4) casing Plastic, 1100"
(material) (depth)
4" if telescope see back.
(size)
 - (5) screen 14', 160'
(length) (depth to top)
008, Plastic
(size) (material)
 - (6) pump 3/4 7
(HP) (yield gpm)
 - elec.
(type power)
 - (7) electric log no
(yes or no)

CODED

(organization running log)

(8) how well bottom plugged back
and


DRILLERS REMARKS:

MAR 13 1969

MISS. BD. OF
WATER COMMISSIONERS

If well telescopes please sketch and show depths.

GROUND LEVEL

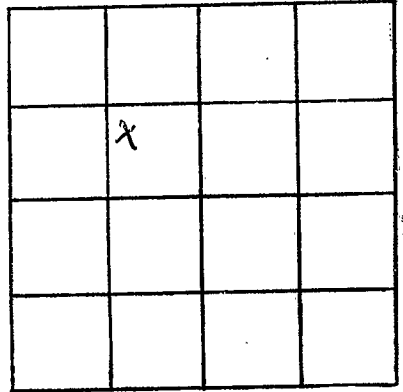

SECTION 1

Please indicate well location X.

ADDITIONAL INFORMATION

If more than one screen, show locations of each on sketch.