

TATE
E12
12-26-70

MISSISSIPPI
BOARD OF WATER COMMISSIONERS
416 North State Street
Jackson, Mississippi 39201

CODED

WATER WELL DRILLERS LOG

Dec 26 1970 date well completed
Shelby Neyman firm name
Tate county well located

LANDOWNER: Herbert Cantelero
R. F. D. - 1
Sarah Mitt,
(mailing address)

WELL LOCATION:
sec. 19 T. 5 N. R. 9 E.
S
1/4 miles SE of Savage
(distance) (direction) (nearest town)

WELL PURPOSE: Home
(home, irrigation, municipal, industrial)

- WELL COMPLETION DATA:
- (1) diameter (inches) 2
 - (2) total depth (feet) 215
 - (3) static water level (feet) 35 below above top of ground.
 - (4) casing Galvange 2 1/2"
(material) (depth)
 - (size) if telescope see back.
 - (5) screen 5 ft
(length) (depth to top)
1/4" Stamless Steel
(size) (material)
 - (6) pump 3/4" 4
(HP) (yield gpm)
Electric
(type power)
 - (7) electric log no
(yes or no)
no
(organization running log)
 - (8) how well bottom plugged Bulb Seal

| description of formations encountered | from | to |
|---------------------------------------|------|-----|
| Red Clay | 0 | 20 |
| Grey Clay | 20 | 70 |
| gravel | 70 | 75 |
| Blue Clay | 75 | 200 |
| Grey Sand | 200 | 215 |

CODED


JAN 7 - 1971

DRILLERS REMARKS:

PRICE PER FOOT
WATER QUANTITY
METERS COURSE

If well telescopes please sketch and show depths.

GROUND LEVEL

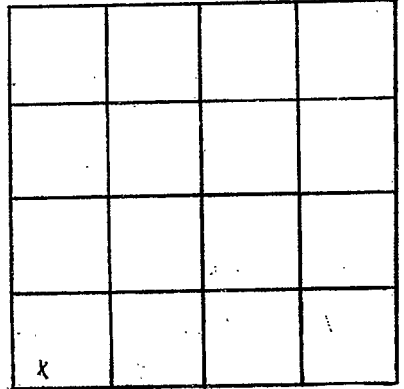

Well.

SECTION 19

Please indicate well location X.

ADDITIONAL INFORMATION

If more than one screen,
show locations of each on sketch.