

TATE  
E13  
12-5-62

WATER WELL DRILLERS LOG

CODED

Date: Aug 5, 19 62; Driller: Sally Rogers County tato

(Name)

(1) Owner of Land: J. B. Sharp  
(Name)  
Leontotis Miss  
(Address)  
34 59

(2) Location: 1/4, 1/4, Sec. T R,  
2 miles east, of Stacy  
(distance) (direction) (Nearest Town)

(3) Topography:  (Hilly)  (Flat)  (Level)

(4) Purpose of Well:   
(Domestic Irrigation  
Municipal, Industrial, Other)

Description & Color of Materials Sand, Clay, Red Clay, Shell, etc.	Thick- ness Feet	Depth Feet
<u>Blue clay</u>	<u>70</u>	
<u>Mulky Blue sand</u>	<u>3</u>	
<u>Blue clay</u>	<u>130</u>	
<u>white sand</u>	<u>16</u>	

Information upon completion of well:

(1) Diameter 2 inches.

(2) Total Depth 2 19 feet.

(3) Water Level 22 feet below top of ground.

(4) Cased to \_\_\_\_\_, Size \_\_\_\_\_.

(5) Screen: Size 90, Length 6ft.


(6) Were any formations sealed against pollution?  
\_\_\_\_\_ yes, \_\_\_\_\_ no.

CODED

If YES depth of formation \_\_\_\_\_

Why \_\_\_\_\_

Drillers Remarks: This well  
is in Strachan  
canal Bottom

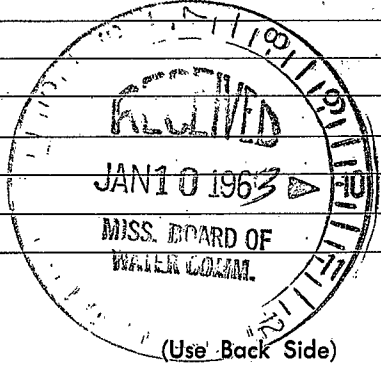

Well No.

