

TATE
E 14
6-14-72

MISSISSIPPI
BOARD OF WATER COMMISSIONERS
416 North State Street
Jackson, Mississippi 39201

WATER WELL DRILLERS LOG

June 14 1972 Shelby Newman Tate
date well completed firm name county well located

LANDOWNER: J.E. Smith
R.F.D. - 1
Coldwater Miss
(mailing address)

description of formations encountered	from	to
Red clay	0	20
Blue clay	20	70

WELL LOCATION:
sec. 9 T 5 N R 9 E
3 miles SW of Arabhatta
(distance) (direction) (nearest town)

sand	70	100
------	----	-----

WELL PURPOSE: Swine Farm
(home, irrigation, municipal, industrial)

- WELL COMPLETION DATA:
- (1) diameter (inches) 4
 - (2) total depth (feet) 100
 - (3) static water level (feet) 20 below above top of ground.
 - (4) casing Plastic 100
(material) (depth)
If telescope see back.
(size)
 - (5) screen 20 ft
(length) (depth to top)
1/2 in Plastic
(size) (material)
 - (6) pump 1 30
(HP) (yield gpm)
Electrol
(type power)
 - (7) electric log no
(yes or no)
no
(organization running log)
 - (8) how well bottom plugged Plastic cap


DRILLERS REMARKS:

JUN 17 1972

MISSISSIPPI
BOARD OF WATER COMMISSIONERS

If well telescopes please sketch and show depths.

GROUND LEVEL

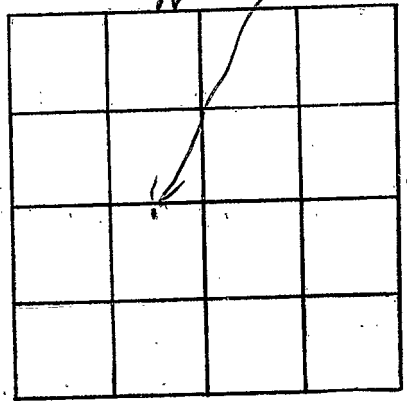

SECTION _____

Please indicate well location X.

ADDITIONAL INFORMATION

If more than one screen, show locations of each on sketch.