

TATE
E 15
6-10-72

MISSISSIPPI
BOARD OF WATER COMMISSIONERS
416 North State Street
Jackson, Mississippi 39201

WATER WELL DRILLERS LOG

June 10 1972 Shelby Newman Tate
date well completed firm name county well located


LANDOWNER:	description of formations encountered	from	to
J. E. Smith R. F. D. - 1	Red clay	0	20
Coldwater Miss (mailing address)	Blue clay	20	90
WELL LOCATION: sec. 9 T. 5 N. R. 9 E. 3 miles SW of Arabouette	Sand	90	140
WELL PURPOSE: Swine Farm (home, irrigation, municipal, industrial)			
WELL COMPLETION DATA: (1) diameter (inches) 4			
(2) total depth (feet) 140			
(3) static water level (feet) 18 below top of ground.			
(4) casing Plastic, 140 (material) (depth)			
(size) If telescope see back.			
(5) screen 20 ft (length) (depth to top)			
4 in Plastic (size) (material)			
(6) pump 1 (HP) 30 (yield gpm)			
Electric (type power)			
(7) electric log no (yes or no)			
no (organization running log)			
(8) how well bottom plugged Plastic cap			
DRILLERS REMARKS:			

JUL 17 1972

MISS. DE. OF
WATER COMMISSIONERS

If well telescopes please sketch and show depths.

GROUND LEVEL

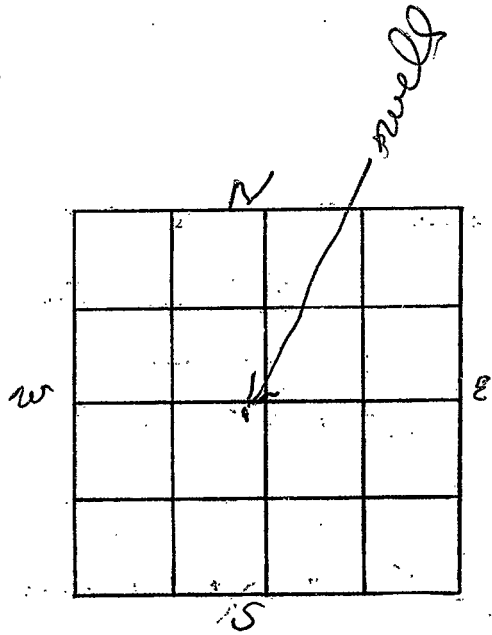

SECTION 9

Please indicate well location X.

ADDITIONAL INFORMATION

If more than one screen, show locations of each on sketch.