

TATE  
E 16  
5-25-72

MISSISSIPPI  
BOARD OF WATER COMMISSIONERS  
416 North State Street  
Jackson, Mississippi 39201

WATER WELL DRILLERS LOG

5-25 1972 Harris Bros. Tate  
date well completed firm name (well) located

LANDOWNER: B. H. Wright  
at 2  
Arkabutta  
(mailing address)  
WELL LOCATION:  
sec 11 T 5 N R 9 E  
3 miles S of Arkabutta  
(distance) (direction) (nearest town)

WELL PURPOSE: none  
(home, irrigation, municipal, industrial)

- WELL COMPLETION DATA:
- diameter (inches) 4
  - total depth (feet) 170
  - static water level (feet) 60 (below above) top of ground.
  - casing Plastic, 156 (material) (depth)  
4 if telescope see back. (size)
  - screen 14, 156 (length) (depth to top)  
008, Plastic (size) (material)
  - pump 1, 15 (HP) (yield gpm)  
elec (type power)
  - electric log no (yes or no)
  - (organization running log)
  - how well bottom plugged solid

description of formations encountered	CODED	
	from	to
top soil	0	20
grey clay	20	65
fine sand & clay	65	140
Course sand	140	170
CODED		


OCT 18 1972

MISS. BD. OF  
WATER COMMISSIONERS

DRILLERS REMARKS: \_\_\_\_\_

If well telescopes please sketch and show depths.

GROUND LEVEL

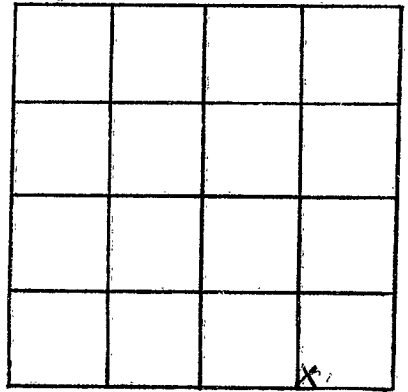

SECTION 11

Please indicate well location X.

ADDITIONAL INFORMATION

If more than one screen,  
show locations of each on sketch.