

TATE
E 17
6-12-72

MISSISSIPPI
BOARD OF WATER COMMISSIONERS
416 North State Street
Jackson, Mississippi 39201

CODED

WATER WELL DRILLERS LOG

6-12-1972 date well completed Harris Bros. firm name Tate county well located

LANDOWNER: St. Peter Church

description of formations encountered

Rt. 2

from to

Arabiatta
(mailing address)

top soil 0 20

WELL LOCATION:

sec. 11 T 5 N R 9 E
3 miles S of Arabiatta
(distance) (direction) (nearest town)

grey clay 20 65

fine sand + clay 65 140

Coarse sand 140 170

WELL PURPOSE: Church
(home, irrigation, municipal, industrial)

WELL COMPLETION DATA:

- (1) diameter (inches) 4
- (2) total depth (feet) 170
- (3) static water level (feet) 60 ^{below} _{above} top of ground.
- (4) casing Plastic, 156 (material), (depth)
4 (size) if telescope see back.
- (5) screen 14 (length), 156 (depth to top)
008, Plastic (size) (material)
- (6) pump 3/4 (HP), 7 (yield gpm)
elec. (type power)
- (7) electric log No (yes or no)
- (8) how well bottom plugged solid

CODED


OCT 18 1972

DRILLERS REMARKS:

MISS. DR. ...
UNITED STATES

If well telescopes please sketch and show depths.

GROUND LEVEL

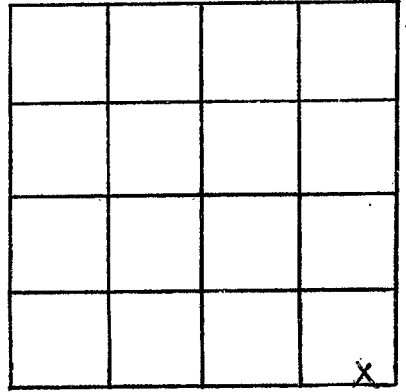

SECTION 11

Please indicate well location X.

ADDITIONAL INFORMATION

If more than one screen,
show locations of each on sketch.