

TATE
E 18
4-3-73

MISSISSIPPI
BOARD OF WATER COMMISSIONERS
416 North State Street
Jackson, Mississippi 39201

WATER WELL DRILLERS LOG

4-2 1973 Harris Bros. Tate
date well completed firm name county well located

LANDOWNER: Flying L Ranch Rt. 1 Larch (mailing address)	description of formations encountered	from	to
	top soil	0	15
	clay	15	45
	clay + sand	45	75
	coarse sand	75	100

WELL LOCATION:
sec. 32 T 5 N R 9 E
10 miles W of Senatobia
(distance) (direction) (nearest town)

WELL PURPOSE: home
(home, irrigation, municipal, industrial)

WELL COMPLETION DATA:

(1) diameter (inches) 4

(2) total depth (feet) 100

(3) static water level (feet) 40 (below/above top of ground)

(4) casing Plastic, 86
(material) (depth)
4 (size) If telescope see back.

(5) screen 14, 86
(length) (depth to top)
008, Plastic
(size) (material)

(6) pump 1, 20
(HP) (yield gpm)
cloes
(type power)

(7) electric log NO
(yes or no)


(organization running log)

(8) how well bottom plugged solid

DRILLERS REMARKS:

If well telescopes please
sketch and show depths.

GROUND LEVEL

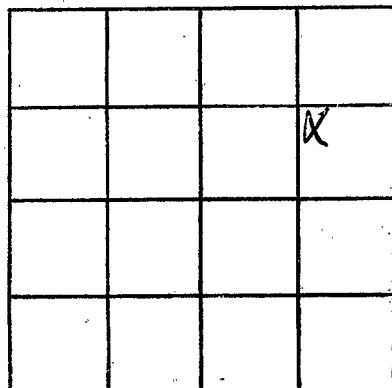

SECTION 32

Please indicate well location X.

ADDITIONAL INFORMATION

If more than one screen,
show locations of each on sketch.