

TATE
E 19
9-10-73

MISSISSIPPI
BOARD OF WATER COMMISSIONERS
416 North State Street
Jackson, Mississippi 39201

WATER WELL DRILLERS-LOG

CODED

9-10 1973 Harris Bros. Tate
date well completed firm name county well located

LANDOWNER: Dennis Dutka Rt. 2 Lenetobia (mailing address)	description of formations encountered	from	to
	top soil	0	20
	clay + sand	20	65
	gray clay	65	150
	fine sand	150	205
	coarse sand	205	230
<p>WELL LOCATION: sec. 15 T-5 N R-9 E 2 1/2 miles N of Strachon (distance) (direction) (nearest town)</p>			
<p>WELL PURPOSE: none (home, irrigation, municipal, industrial)</p>			
<p>WELL COMPLETION DATA:</p>			
(1) diameter (inches) 4			
(2) total depth (feet) 230			
(3) static water level (feet) 120 ^{below} top of ground.			
(4) casing <u>Plastic</u> , 216 (material) (depth)			
4 (size) if telescope see back.			
(5) screen 14, 216 (length) (depth to top)			
008, Plastic (size) (material)			
(6) pump 3/4, 7 (HP) (yield gpm)			
elec. (type power)			
(7) electric log <u>NO</u> (yes or no)			
(organization running log)			
(8) how well bottom plugged <u>solid</u>			
DRILLERS REMARKS:			


CODED

067 283 1973

MISS. DE. OF
WATER RESOURCES

If well telescopes please sketch and show depths.

GROUND LEVEL

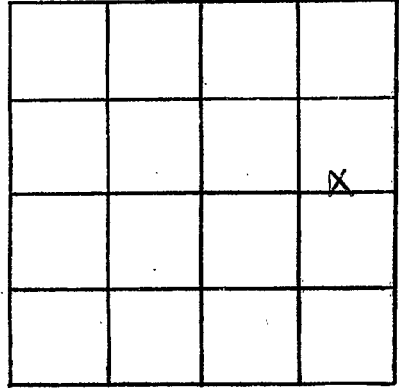

SECTION 15

Please indicate well location X.

ADDITIONAL INFORMATION

If more than one screen,
show locations of each on sketch.