

LATE
E 21
9-29-73

MISSISSIPPI
BOARD OF WATER COMMISSIONERS
416 North State Street
Jackson, Mississippi 39201

WATER WELL DRILLERS LOG

CODED

9-29

1973

Harris B...

date

date well completed

firm name

county well located

LANDOWNER:

John W. Wildman
Rt. 2 Senatobia
(mailing address)

description of formations encountered

from

to

top soil 0 20

sand + gravel 20 45

Clay 45 145

fine sand + clay 145 245

Coarse sand 245 270

WELL LOCATION:

sec. 15 T 5 N R 9 E

2 1/2 miles N of Sturgis
(distance) (direction) (nearest town)

WELL PURPOSE:

name (home, irrigation, municipal, industrial)

WELL COMPLETION DATA:

- (1) diameter (inches) 4
- (2) total depth (feet) 270
- (3) static water level (feet) 20 ^{below} top of ground.

- (4) casing Plastic 256 (material) (depth)

4 (size) If telescope see back.

- (5) screen 14 256 (length) (depth to top)

108 Plastic (size) (material)

- (6) pump 3/4 7 (HP) (yield gpm)

elec. (type power)

- (7) electric log no (yes or no)

(organization running log)

- (8) how well bottom plugged solid


DRILLERS REMARKS:

CODED

SEP 28 1973

If well telescopes please sketch and show depths.

GROUND LEVEL

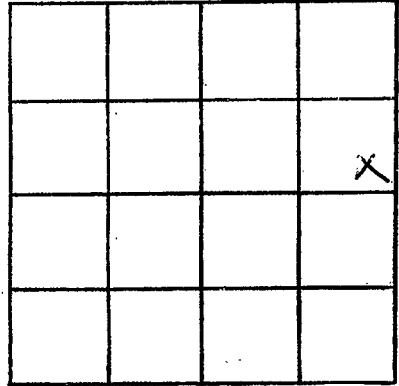

SECTION 15

Please indicate well location X.

ADDITIONAL INFORMATION

If more than one screen, show locations of each on sketch.