

TATE
E 22
11-20-73

MISSISSIPPI
BOARD OF WATER COMMISSIONERS
416 North State Street
Jackson, Mississippi 39201

CODED

WATER WELL DRILLERS LOG

Nov. 20 1973 date well completed
Shelly, Neyman firm name
Tate county well located

LANDOWNER:

Robert Waldneft

description of formations
encountered

from to

P. 7 Dr - 1

Red clay 0 40

Coldwater Miss

(mailing address)

Gravel 40 70

WELL LOCATION:

sec. 4 T 5 N R. 9
2 1/2 miles S W of Arabona
(distance) (direction) (nearest town)

White clay 70 76

White Sand 76 130

WELL PURPOSE: Home
(home, irrigation, municipal, industrial)

WELL COMPLETION DATA:

- (1) diameter (inches) 4
- (2) total depth (feet) 130
- (3) static water level (feet) 75 below above top of ground.
- (4) casing Plastic 130.
(material) (depth)
(size) if telescope see back.
- (5) screen 20 ft.
(length) (depth to top)
4 in Plastic
(size) (material)
- (6) pump 3/4 HP 20
(HP) (yield gpm)
Electric
(type power)
- (7) electric log No
(yes or no)
No
(organization running log)
- (8) how well bottom plugged Cop


CODED

JAN 2 1974

DRILLERS REMARKS:

If well telescopes please sketch and show depths.

GROUND LEVEL

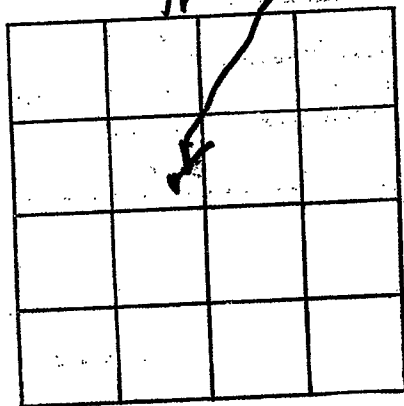

5
SECTION ~~4~~

Please indicate well location X.

ADDITIONAL INFORMATION

If more than one screen, show locations of each on sketch.