

MISSISSIPPI
BOARD OF WATER COMMISSIONERS
416 North State Street
Jackson, Mississippi 39201

CODED

WATER WELL DRILLERS LOG

LATE
E 23
1-10-74

1-10 date well completed 1974 Harris Bros. firm name Late county well located

LANDOWNER: <u>Dennis Massey</u>	Description of formations encountered	from	to
<u>RT 1</u>	<u>top soil</u>	<u>0</u>	<u>25</u>
<u>Senatobia</u> (mailing address)	<u>clay + fine sand</u>	<u>25</u>	<u>60</u>
WELL LOCATION: sec. <u>26</u> T. <u>5</u> N. R. <u>9</u> E. <u>2</u> miles <u>E</u> of <u>Strasburg</u> (distance) (direction) (nearest town)	<u>gray clay</u>	<u>60</u>	<u>140</u>
WELL PURPOSE: <u>none</u> (home, irrigation, municipal, industrial)	<u>fine sand</u>	<u>140</u>	<u>195</u>
WELL COMPLETION DATA: (1) diameter (inches) <u>4</u>	<u>Coarse sand</u>	<u>195</u>	<u>210</u>
(2) total depth (feet) <u>210</u>			
(3) static water level (feet) <u>100</u> ^{below} / _{above} top of ground.			
(4) casing <u>Plastic</u> , <u>196</u> (material) (depth)			
<u>4</u> (size) if telescope see back.			
(5) screen <u>14</u> , <u>196</u> (length) (depth to top)			
<u>no. 8</u> , <u>Plastic</u> (size) (material)			
(6) pump <u>3/4</u> , <u>10</u> (HP) (yield gpm)			
<u>elec.</u> (type power)			
(7) electric log <u>no</u> (yes or no)			
(organization running log)			
(8) how well bottom plugged <u>solid</u>			


CODED

DRILLERS REMARKS:

DEPT. OF REVENUE
FEB 22 1974

If well telescopes please sketch and show depths.

GROUND LEVEL

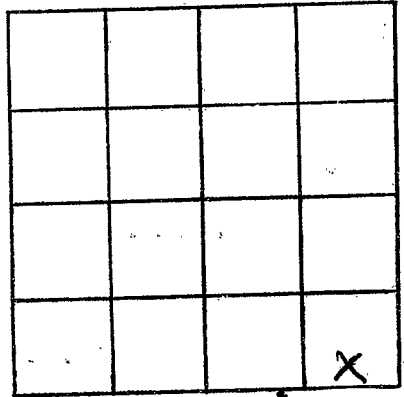

SECTION 26

Please indicate well location X.

ADDITIONAL INFORMATION

If more than one screen,
show locations of each on sketch.