

TATE
E 24
4-20-74

MISSISSIPPI
BOARD OF WATER COMMISSIONERS
416 North State Street
Jackson, Mississippi 39201

CODED

WATER WELL DRILLERS LOG

4-20 date well completed 1974 Bob Smith & Son firm name Tate county well located


LANDOWNER:	description of formations encountered	from	to
Charles Ross Strayhorn Sarah, Miss (mailing address)			
WELL LOCATION:	Red Clay	5'	10'
sec. 28 T 5 N R 9 E 2 miles N of Strayhorn (distance) (direction) (nearest town)	Gravel	10'	30'
WELL PURPOSE: Home (home, irrigation, municipal, industrial)	Blue clay	30'	200'
WELL COMPLETION DATA:	Sand	200'	260'
(1) diameter (inches) 4			
(2) total depth (feet) 260			
(3) static water level (feet) 48 below top of ground.			
(4) casing Plastic 260 (material) (depth)			
(size) If telescope see back.			
(5) screen 10 250 (length) (depth to top)			
4 Plastic (size) (material)			
(6) pump 1/2 10 (HP) (yield gpm)			
Electric (type power)			
(7) electric log no (yes or no)			
(organization running log)			
(8) how well bottom plugged plugged			
DRILLERS REMARKS:			

CODED

RECEIVED
JUN 21 1974

If well telescopes please sketch and show depths.

GROUND LEVEL

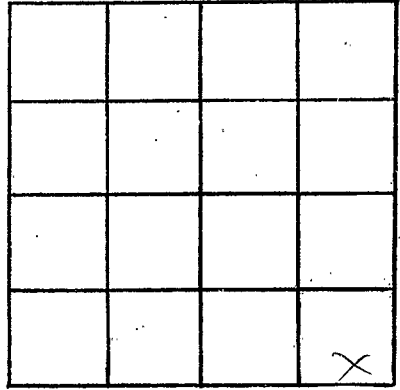

SECTION 28

Please indicate well location X.

ADDITIONAL INFORMATION

If more than one screen, show locations of each on sketch.