

TATE
 PANOLA
 E 25
 9-20-74

MISSISSIPPI BOARD OF WATER COMMISSIONERS
 416 North State Street
 Jackson, Mississippi 39201

CODED

WATER WELL DRILLERS LOG

TATE

Sept 20 1974 Bob Smith Well Drilling Panola
 date well completed firm name county well located

LANDOWNER: Harry Leeding
Strayhorn, Miss.
 (mailing address)

description of formations encountered	from	to
Clay gravel	0	40
white clay	40	70
Blue clay	70	160
fine sand	160	180
Course sand	180	230

WELL LOCATION:
 sec. 14 T 5 N R 9 E
3 miles N of Strayhorn
 (distance) (direction) (nearest town)

WELL PURPOSE:
 (home, irrigation, municipal, industrial)

WELL COMPLETION DATA:

(1) diameter (inches) 4

(2) total depth (feet) 230

(3) static water level (feet) 79 below top of ground.

(4) casing Plastic 230'
 (material) (depth)

(size) if telescope see back.

(5) screen 4" 10'
 (length) (depth to top)

4 Plastic
 (size) (material)

(6) pump 1/2 10
 (HP) (yield gpm)

electric
 (type power)

(7) electric log No
 (yes or no)

(organization running log)


(8) how well bottom plugged Plugged

DRILLERS REMARKS:

RECEIVED
 SEP 26 1974

If well telescopes please sketch and show depths.

GROUND LEVEL

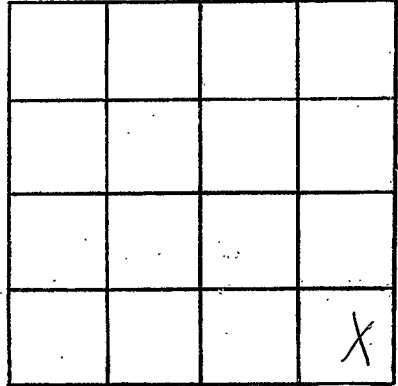

SECTION 14

Please indicate well location X.

ADDITIONAL INFORMATION

If more than one screen, show locations of each on sketch.