

TATE  
E 26  
10-15-74

MISSISSIPPI  
BOARD OF WATER COMMISSIONERS  
416 North State Street  
Jackson, Mississippi 39201

WATER WELL DRILLERS LOG CODED

10-15 1974 date well completed  
Harris Bros. firm name  
Tate county well located

LANDOWNER: Memphis  
Christian College  
PO Box 588 Senatobia  
(mailing address)

description of formations encountered	from	to
top soil	0	20
sand + gravel	20	45
gray clay	45	160
clay + fine sand	160	260
coarse sand	260	300

WELL LOCATION:  
sec. 15 T. S N R. 9 E <sup>15E</sup>  
34 miles S of Eliphoz  
(distance) (direction) (nearest town)

WELL PURPOSE:  
(home, irrigation, municipal, industrial)


- WELL COMPLETION DATA:
- diameter (inches) 4
  - total depth (feet) 300
  - static water level (feet) 120 <sup>below</sup> <sub>above</sub> top of ground.
  - casing Plastic, 272,  
(material) (depth)  
4 if telescope see back.  
(size)
  - screen 28, 272  
(length) (depth to top)  
008, Plastic  
(size) (material)
  - pump 3, 30  
(HP) (yield gpm)  
elec.  
(type power)
  - electric log no  
(yes or no)
- (organization running log)
- (8) how well bottom plugged solid

DRILLERS REMARKS:

RECORDED  
INDEXED  
MAR 17 1975  
MISS. Bd. OF WATER COMM.

If well telescopes please sketch and show depths.

GROUND LEVEL

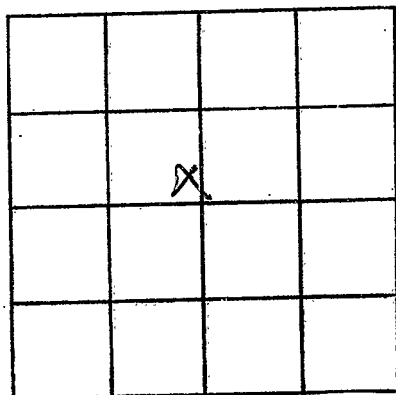

SECTION 15

Please indicate well location X.

ADDITIONAL INFORMATION

If more than one screen, show locations of each on sketch.