

TATE
E 28
5-2-79

MISSISSIPPI
 BOARD OF WATER COMMISSIONERS
 416 North State Street
 Jackson, Mississippi 39201

CODED

WATER WELL DRILLERS LOG

5-2 1979 Dicks Well Co. Tate
 date well completed firm name county well located

LANDOWNER:
Robert Thomas
Rt. 3, Senatobia
 (mailing address)

description of formations encountered	from	to
<u>Red Clay</u>	<u>0</u>	<u>30</u>
<u>Sand & Gravel</u>	<u>30</u>	<u>90</u>
<u>Black Clay</u>	<u>90</u>	<u>150</u>
<u>White Sand</u>	<u>150</u>	<u>240</u>

WELL LOCATION:
 sec. 14 T. 5 N. R. 9 E.
2 1/4 miles North of Rayham
 (distance) (direction) (nearest town)

WELL PURPOSE: Industrial
 (home, irrigation, municipal, industrial)

WELL COMPLETION DATA:

(1) diameter (inches) 6 1/2 in

(2) total depth (feet) 240

(3) static water level (feet) 122 below top of ground.

(4) casing Plastic 240
 (material) (depth)

(size) if telescope see back.

(5) screen 40 ft, 200 ft
 (length) (depth to top)
6 in, slotted
 (size) (material)

(6) pump 25 350
 (HP) (yield gpm)
440
 (type power)

(7) electric log No
 (yes or no)

(organization running log)

(8) how well bottom plugged Cap

CODED

Miss. Board of Water Comm.


MAY 15 1979

RECEIVED

DRILLERS REMARKS:

If well telescopes please sketch and show depths.

GROUND LEVEL

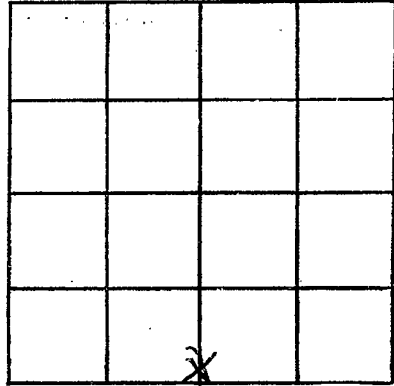

SECTION 14

Please indicate well location X.

ADDITIONAL INFORMATION

If more than one screen, show locations of each on sketch.