

MISSISSIPPI DEPARTMENT OF NATURAL RESOURCES

Bureau of Land and Water Resources

Southport Mall

P.O. Box 10631

CODED

Jackson, Mississippi 39209

WATER WELL DRILLERS LOG

E-29
11150
TATE

7-11 1980 date well completed 80 High Wells firm name Tate county well located

LANDOWNER:	description of formations encountered	from	to
Raymond Busby	clay	0	30
(mailing address)	gravel	30	60
WELL LOCATION:	Black clay	60	130
sec. 23 T. 5 N. R. 9 E. Strayhorn miles of (distance) (direction) of (nearest town)	white sand	130	185
WELL PURPOSE: (home, irrigation, municipal, industrial)	CODED		
WELL COMPLETION DATA:			
(1) diameter (inches) 4 in			
(2) total depth (feet) 185			
(3) static water level (feet) 160 below top of ground.			
(4) casing (material) Plastic (depth) 185			
(size) if telescope see back.			
(5) screen (length) 1 ft (depth to top) 178			
(size) 4 in (material) gravel			
(6) pump (HP) 1/2 (yield gpm) 10			
(type power) 220			
(7) electric log No (yes or no)			
(organization running log)			
(8) how well bottom plugged Cap			
DRILLERS REMARKS:			


DEPT. OF NATURAL RESOURCES
BUREAU OF LAND & WATER RESOURCES

SEP 4 1980

RECEIVED

If well telescopes please sketch and show depths.

GROUND LEVEL

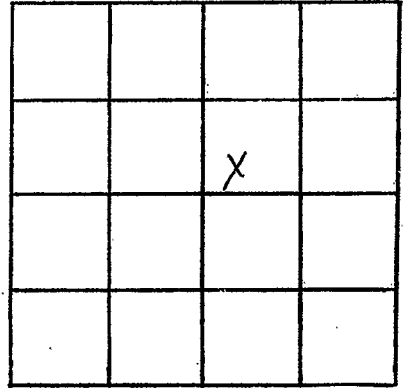

SECTION 23

Please indicate well location X.

ADDITIONAL INFORMATION

If more than one screen,
show locations of each on sketch.