	State Well Report	
Th	Part 1 – Driller's Log	For Office Use Only:
County: 70te	Mississippi Department of Environmental Quality	Aquifer:
Permit #:		Well #: E - 55
Driller: Jones W. Mason	P.O. Box 10631	Well #: <u>35</u>
Driller: JOWES CO: 1108362	Jackson, MS 39289-0631	L. S. Elevation:
Date drilling completed: 1 - 07	(601)961-5210	
	(601)354-6938 (fax)	E-log #:

٦ ۲

State Law requires that this report be prepared by the license holder responsible for the work and filed with the Department at the above address within 30 days of completion of drilling of the well or borehole.


Information on Well Owner	Well or Borehole Location					
(Landowner if borehole is not for a water well)	34 410 39					
Owner Name Air and Heat Services	Latitude: <u>34 ° 40</u> , <u>18</u> , Longitude: <u>90 °08</u> , <u>15</u> Method of Lat/Long (circle one): Conventional Survey,					
Mailing Address: <u>Corper low rd</u>	USGS quad, (Hand-heid GPS) Survey-grade GPS					
12 drive to left at end	Nor 1/4 SEC /4 Sec Twn 55 Rng 9w					
City State Zip Code	SE SW 3 Distance Direction Nearest Town 112 Miles SUS of arkabutla					
Telephone No. 662 838 - 8088	<u>l'la Miles Sus of arkabutla</u>					
Well / Borehole Data						
Date drilling started: $10 - 36 - 0$ Date drilling completed: $10 - 36 - 0$ Hole depth: $330'$ Hole diameter: $5''$						
Location of the source of any surface water used for drilling: <u>NA</u> Method of dosing and volume of Chlorine used in drilling and development: <u>NA</u>						
Logs run (circle all applicable): No log run: Electric Gamma Ray Density Sonic Neutron Other:						
Purpose of borehole (check one): Water Well Geotechnical/Geological Investigation Ground Source Heat Pump						
Seismic SurveyOther (describe) If drilling is not related to water well construction, skip the remainder of this block						
Purpose of Well (check one): Home Industrial Public Supply Irrigation Fish Culture Other:						
If a flowing well, method of flow regulation: Valve Other (describe)						
Static Water Level:feet above or below (circle one) land surface Date measured:						
Method of Measurement (circle one) steel tape electric tape air line other:						
Well depth: Well grouted to a depth offeet Type of grout (circle one): Neat Cement Bentonite Mix						
Casing length:feet Casing diameter:inches Type of casing:						
Screen length: feet Screen diameter: inches Type of screen:						
Screen slot size:inches Setting depth: From _	feet tofeet					
Type of completion (circle all applicable): Gravel packed Unde	rreamed Telescoped Open hole Natural Development					
Other (describe):						
Top of lap pipe or reduction in casing:feet. If telescoped or more than one screen, describe on next page						
Form: OLWR-SWR-1/						

RECEIVED NOV 27 2007 BY: OLWR

- 55


The sketch below only required for water wells

If well telescopes, show depths on sketch. Ground Level.

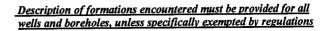

Description of Formations Encountered	From (depth) Ground Level	1.34
cley dirt	- Orbana Lever	30
gravel		60
Cioy	30	
grovel	02 02 08	28
Sond		33
		L
		+
		<u> </u>
		<u> </u>
		+
	_ <u></u>	+

If more than one screen, show location of each on sketch

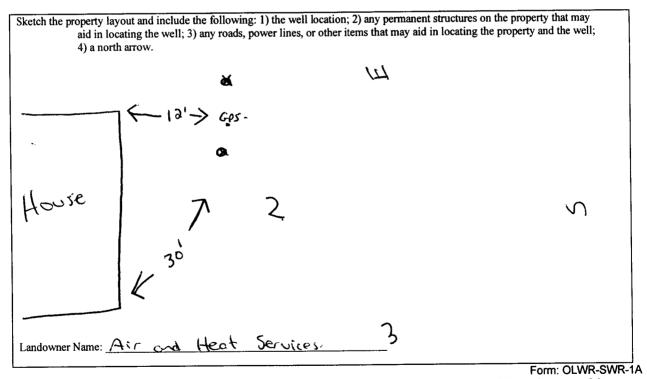

I certify that the well/borehole was drilled, constructed, and completed in accordance with all applicable requirements of the Mississippi Department of Environmental Quality and the Mississippi Department of Health regulations, if applicable, and state

Date

laws. 0-670 Majon Janes LAL.

11-22-07

Print Name of Responsible Licensee and License No.

Signature of Licensee

NOV 27 2007 BY: OLWR

RECEIVED