· •
County:
Permit #:
Driller: BOB Smith
Date drilling complet: 924-08

ŀ

State Well Report

Part 1

Mississippi Department of Environmental Quality

Office of Land and Water Resources

P.O. Box 2309	
Jackson, MS 39225	

For Office	Use Only
Aquifer:	
Well #: (0
L.S. Elevation:	
E-Long #:	

BY: OLWR

State Law requires that this report be prepared by the driller in detail and filled will the Department within 30 days of completion of drilling of the well.

Well Owner Information	Well Location
Owner Name: (INCENT JONES Latitude	e:' "Longitude: "
Nal Internal	of Lat/Long (circle one): Conventional Survey,
	USGS quad, Hand-held GPS, Survey-grade GPS
	1/4 Sect-14 Twn 155 Rng 19 w
City State Zip Code Distanc	· · · · · · · · · · · · · · · · · · ·
Telephone No. 662 560- 3224 3	Miles 5 of ANKABUTCA
Well Data	
Purpose of Well (circle one) frome Industrial Public Supply	y Irrigation Fish Culture Other
Date well drilling started: 9-24-08 Date well	drilling completed: 9.24-08
If flowing, method of flow regulation: Valve Oth	er (describe)
Static Water Level: <u>38</u> feet above or below (circle o	ne) land surface Date measured: <u>7-24</u> -08
Method of Measurement (circle one) steel tape electric ta	pe air line other: $LINET WE(ftheta)$
Hole Depth: 150 Well depth: 150 Well grou	ted to a depth of feet
	Aix
Casing length: 140 feet Casing diameter: 4	
Screen length: 10 feet Screen diameter: 4	inches Type of screen: <u>PVC</u>
Screen slot size: 13700. inches Setting depth: F	from 140 feet to 150 feet
Type of completion(circle all applicable):	
Gravel packed Underreame Other (describe): しんず	the Solution of the second dependence of the s
Top of lap pipe or reduction incasing:feet. If telesc	oped or more than one screen, describe on back
Logs run(circle one): No log run Electric Gamma Ray Densi	ty Sonic Neutron Other:
Name of oorganization running log(s):	
I certify that the well drilled, constracted, and completed in accordance t	
Department of Environmental Quality and/or the Mississippi Department	
BOB Smipt 0645	The RECEIVED
Print name of Water Contractor and License No.	Signature of Water Well Contractor OCT 1 6 2008

* \$	State Well Report	For Office Use Only
County: TATE	Part 2	Aquifer:
Permit #:	Pump Installer's Completion Report	Well #:
Driller: BOB Smat	Mississippi Department of Environmental Quality	Elevation:
Date completed: 9-24-08	Office of Land and Water Resources	
	P.O. Box 2309	
	Jackson, MS 39225	
This report be prepared by the pump installer in detail and filled will the Department within		

3.

Well Owner Information	Well Location	
Owner Name: VINENT JONES Mailing Address: 2636 106 FOOT OUDWATH, MS-386/8 City State Zip Code Telephone No. 664 360 - 3224	Latitude: Longitude: Method of Lat/Long (circle one): Conventional Survey USGS quad, Hand-held GPS, survey grade GPS 1/4 1/4 Sec F/Y Twn TSS Rng_R9w Distance Direction Nearest Town 3 miles S	
Pump Type Circle one Air lift Jet Submersible Bucket Piston Bucket Piston Centrifugal Rotary Flowing Well Other (specify): Date Pump Installed: 9-24-08 Rated Pump Capacity: gallons per min	Power Type Circle one Diesel Engine Gasoline Engine Natural Gas Electric Moto Hand Tractor PTO Windmill Other(specify):	
Pump Test Data Date Well Tested: 9-24-08 Static Water Level(A): 38 feet below Land Surface Rumping Water Level(B): feet below Land Surface	Method of Measuring Water Level circle one Air Line Electric Measuring Line Steel Tape Other(specify): <u>「 」いそ て い E16 せ</u> の	
Drawdown[(B)-(A)]:feet below Land Surface	For flowing well, measured shut in head:feet	

30 days of completion of drilling of the well.

I HEREBY CERTIFY that the above statements are tru	e to the best of my knowledge.	/
Bes Smoot 0645	That	A
Print Name of Pump Installer and License No.	Signature of Pump Installer	


RECEIVED

GPM with a drawdown of

hours of pumping

Ground Level	- Description of Formations Encountered	E-61	To
	TOP Serce	0	3
	BROWN CIM		18
	CARVEL	B	27
	Gref CIAL	27	107
	poc a	107	118
	WITTE Son	188	150
,			
			—
			1

If more than one screen, show location of each on sketch

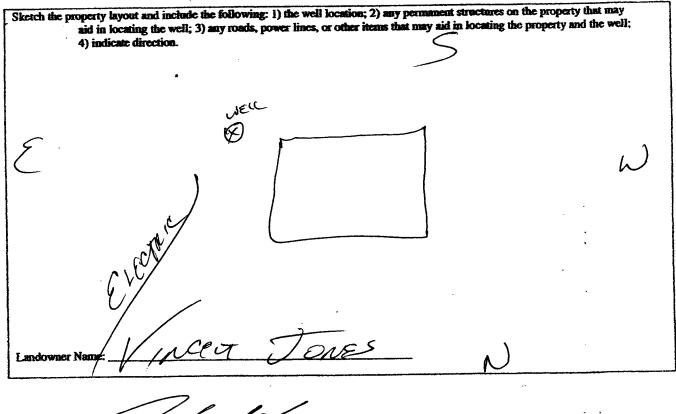

Signature of Water Well Contracts

RECEIVED DCT 16 2008 BY: OLWR