

MISSISSIPPI BOARD OF WATER COMMISSIONERS

WATER WELL DRILLERS LOG

Date: July 11, 1966, Driller: Shelly Meyman County Itate  
(Name)


(1) Owner of Land:	Description & Color of Materials <small>(Sand, Clay, Red Clay, Shell, etc.)</small>	Thick- ness Feet	Depth Feet
<u>Fateco, School</u> <small>(Name)</small> <u>of Strayhorn</u> <small>(Address)</small>	<u>Red clay</u>	<u>20</u>	
(2) Location: <u>NE 1/4, NE 1/4, Sec. 33 T5 R9</u> <u>1/4</u> miles <u>W</u> of <u>Strayhorn</u> <small>(distance) (direction) (Nearest Town)</small>	<u>Dark clay</u>	<u>25</u>	
(3) Topography: <u>W</u> <small>(Hilly) (Flat) (Level)</small>	<u>sand</u>	<u>3</u>	
(4) Purpose of Well: <u>✓</u> <small>(Domestic Irrigation Municipal, Industrial, Other)</small>	<u>Dark clay</u>	<u>30</u>	

Information upon completion of well:

(1) Diameter 3 inches.  
 (2) Total Depth 218 feet.  
 (3) Water Level 40 feet below top of ground.  
 (4) Cased to 210, Size 3"  
 (5) Screen: Size 6, Length 6ft  
 (6) Were any formations sealed against pollution?  
 \_\_\_\_\_ yes, ✓ no.

white clay 110  
white sand 30

If YES depth of formation \_\_\_\_\_  
 Why \_\_\_\_\_  
 Drillers Remarks: \_\_\_\_\_

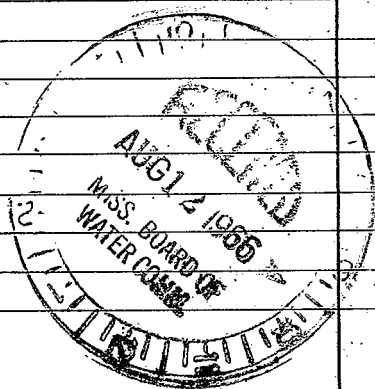

(Use Back Side)

Well No.

