

MISSISSIPPI  
BOARD OF WATER COMMISSIONERS  
416 North State Street  
Jackson, Mississippi 39201

WATER WELL DRILLERS LOG


Tate  
E 2002  
12-66

Dec 16, 1966 Shelby Meyman Tate  
date well completed firm name county well located

LANDOWNER:	description of formations encountered	from	to
<u>Jurley Bros</u>	<u>Blue Block Clay</u>	<u>0</u>	<u>10</u>
<u>Savage Miss.</u> (mailing address)	<u>Gravel</u>	<u>60</u>	<u>67</u>
WELL LOCATION: sec. <u>18</u> T <u>5</u> N R <u>9</u> E S W <u>3</u> miles <u>N-E</u> of <u>Savage</u> (distance) (direction) (nearest town)	<u>White Sand</u>	<u>67</u>	<u>92</u>

WELL PURPOSE: Home  
(home, irrigation, municipal, industrial)


- WELL COMPLETION DATA:
- (1) diameter (inches) 2
  - (2) total depth (feet) 92
  - (3) static water level (feet) 28 below top of ground.
  - (4) casing Metal 84  
(material) (depth)
  - No if telescope see back.  
(size)
  - (5) screen 6ft (length) (depth to top)  
20% metal  
(size) (material)
  - (6) pump Hand Pump H  
(HP) (yield gpm)
  - By Hand  
(type power)
  - (7) electric log No (yes or no)  
No  
(organization running log)
  - (8) how well bottom plugged Metal Point

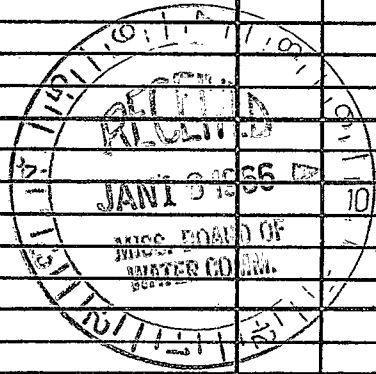

DRILLERS REMARKS:

If well telescopes please sketch and show depths.

GROUND LEVEL

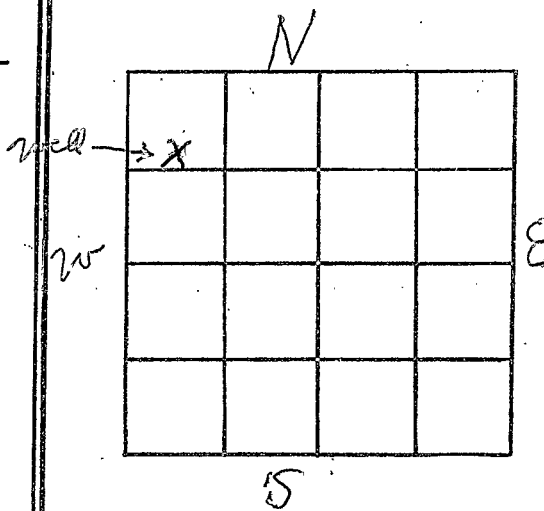

SECTION \_\_\_\_\_

Please indicate well location X.

ADDITIONAL INFORMATION

If more than one screen, show locations of each on sketch.