

MISSISSIPPI

BOARD OF WATER COMMISSIONERS

416 North State Street

Jackson, Mississippi 39201

WATER WELL DRILLERS LOG

Tate

E 2004

1-67

Jan 26

date well completed

Shelby Keyman

firm name

Tate

county well located

LANDOWNER: Jimmie Baker
R. 7, D. - 1
Coldwater Miss
(mailing address)

WELL LOCATION:
sec. 7 T 5 N R 9 E
3 miles NORTH, Savage Miss.
(distance) (direction) (nearest town)

WELL PURPOSE: Home
(home, irrigation, municipal, industrial)

WELL COMPLETION DATA:
(1) diameter (inches) 2
(2) total depth (feet) 154
(3) static water level (feet) 66 below top of ground
(4) casing galvanized 147 (material) (depth)

if telescope see back.
(5) screen 10" (size) 6 ft (length) (depth to top)
1 1/4 in standard steel (size) (material)

(6) pump 3/4 (HP) 4 (yield gpm)
Electric (type power)

(7) electric log no (yes or no)
no (organization running log)


(8) how well bottom plugged Rubber Seal

Description of formations encountered	from	to
Red clay	0	40
gravel	40	50
white or grey clay	50	80
Mixture of white clay & sand	80	140
clear white sand	140	154

DRILLERS REMARKS:

If well telescopes please sketch and show depths.

GROUND LEVEL

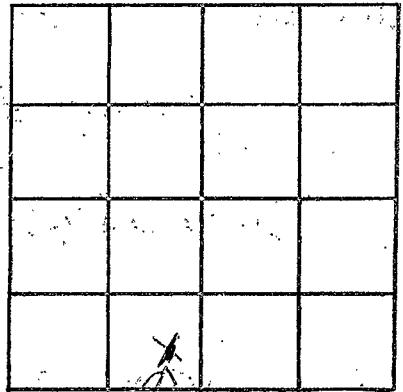

SECTION _____

Please indicate well location X.

ADDITIONAL INFORMATION

If more than one screen,
show locations of each on sketch.