

Date
 E 2005
 7-67

MISSISSIPPI
 BOARD OF WATER COMMISSIONERS
 416 North State Street
 Jackson, Mississippi 39201

WATER WELL DRILLERS LOG

July 10 1967 Shelby Neyman Date
 date well completed firm name county well located

LANDOWNER: Al L Mc Iver
Coldwater Mills
R. F. D. - 1
 (mailing address)


WELL LOCATION:
 sec. 13 T 5 N R 10 E
 S W
 2 1/2 miles NE of Savage
 (distance) (direction) (nearest town)

WELL PURPOSE:
 (home, irrigation, municipal, industrial)

WELL COMPLETION DATA:

- (1) diameter (inches) 7
- (2) total depth (feet) 135
- (3) static water level (feet) 60 below above top of ground.
- (4) casing Galvane (material) (depth)
- if telescope see back.
- (5) screen Johnson (size) 1/2 (length) 6 (depth to top)
- (size) (material)
- (6) pump 1 (HP) 7 (yield gpm)
- Electric (type power)
- (7) electric log no (yes or no)
- no (organization running log)
- (8) how well bottom plugged Rubber Seal

description of formations encountered	from	to
<u>Grey Clay</u>	<u>0</u>	<u>56</u>
<u>White Sand</u>	<u>56</u>	<u>58</u>
<u>Grey Clay</u>	<u>58</u>	<u>90</u>
<u>Mixture of Grey Clay</u>		
<u>Grey Sand</u>	<u>120</u>	<u>140</u>
<u>Clear Sand</u>	<u>140</u>	<u>135</u>

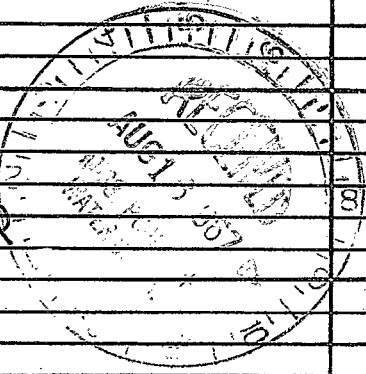

DRILLERS REMARKS:

