


Tate
E 2000
1-67

MISSISSIPPI
BOARD OF WATER COMMISSIONERS

416 North State Street
Jackson, Mississippi 39201

WATER WELL DRILLERS LOG

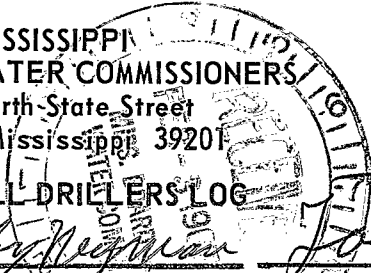

Jan 31 1967 Shelby Noyman Jule
date well completed firm name county well located

By Jerry Baker
LANDOWNER Mrs Ann
Powell Spragens 9nd
Mrs John O Powell
Senator (mailing address)

description of formations encountered	from	to
Red Clay	0	38
Red Sand	38	41
Blue Clay	41	85
gravel	85	97
grey sand	97	108

WELL LOCATION:
sec. 8 T 5 N R 9 E
S W
4 miles S W of arholata
(distance) (direction) (nearest town)

WELL PURPOSE:
(home, irrigation, municipal, industrial)

- WELL COMPLETION DATA:
- (1) diameter (inches) 2
 - (2) total depth (feet) 108
 - (3) static water level (feet) 38 below top of ground
 - (4) casing galvanized iron (material) 100 (depth)
 - (5) screen 6 ft (length) 100 (depth to top)
 - (6) pump Hand pump 4-10 (HP) (yield gpm)
 - (7) electric log No (yes or no)
 - (8) how well bottom plugged Rubber Seal

DRILLERS REMARKS:

