

**MISSISSIPPI
BOARD OF WATER COMMISSIONERS**
416 North State Street
Jackson, Mississippi 39201

WATER WELL DRILLERS LOG

Late
E 2007
6-67

June 28 19 *67* *Shelby Neyman* *Late*
date well completed firm name county well located

LANDOWNER: *Mrs. Bessie White*
cold water Miss
R. F. D. - 1
(mailing address)

description of formations encountered	from	to
<i>Red clay</i>	<i>00</i>	<i>60</i>
<i>Red sand & gravel</i>	<i>60</i>	<i>80</i>
<i>Red gravel</i>	<i>80</i>	<i>96</i>


WELL LOCATION:
sec. *5* T. *5* S. R. *9* E.
3 miles *SW* of *Arkabutla*
(distance) (direction) (nearest town)

WELL PURPOSE: *Home*
(home, irrigation, municipal, industrial)

WELL COMPLETION DATA:

- (1) diameter (inches) *2 in*
- (2) total depth (feet) *96*
- (3) static water level (feet) *84* below top of ground.
- (4) casing *Galvanized* *90*
(material) (depth)
- _____ if telescope see back.
- (5) screen *6 in* *90* *Gal.*
(size) (length) (depth to top)
- 1 1/2*
(size) _____ (material)
- (6) pump *1/2* *Red pump* *6* *G.P.M.*
(HP) (yield gpm)
- Electric*
(type power)
- (7) electric log *no*
(yes or no)
- no*
(organization running log)
- (8) how well bottom plugged *Pushy*


DRILLERS REMARKS:

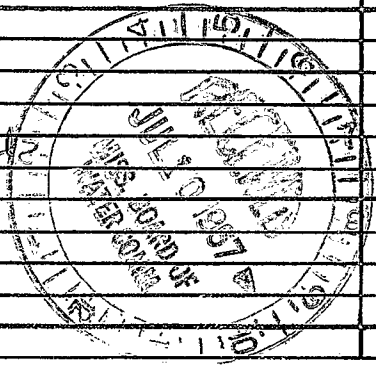

If well telescopes please sketch and show depths.

GROUND LEVEL

WELL

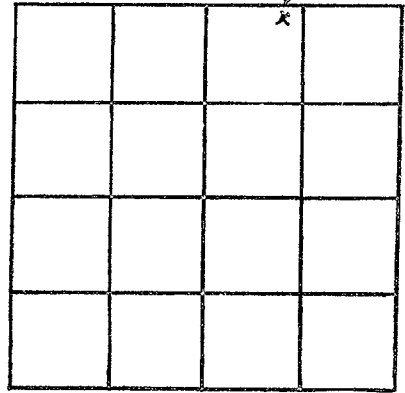

SECTION 5

Please indicate well location X.

ADDITIONAL INFORMATION

NE Coy W^r NE^r Sec 5

If more than one screen, show locations of each on sketch.