

Tate
E 2008
9-67

MISSISSIPPI
BOARD OF WATER COMMISSIONERS
416 North State Street
Jackson, Mississippi 39201

WATER WELL DRILLERS LOG

Sept 22 1967 Shelby Negovan Tate
date well completed firm name county well located

LANDOWNER: Kelly Carlisle
Sarah Miss

description of formations encountered	from	to
Red Clay	0	60
Sand & Gravel	60	100
quartz Sand	100	112

(mailing address)

WELL LOCATION:
sec. 22 T. 5 N. R. 9 E.
S W
1 miles N of Straphorn
(distance) (direction) (nearest town)

WELL PURPOSE: Home
(home, irrigation, municipal, industrial)

- WELL COMPLETION DATA:
- (1) diameter (inches) 2
 - (2) total depth (feet) 112
 - (3) static water level (feet) 85 below top of ground.
 - (4) casing Galvanize (material) (depth)
 - (size) if telescope see back.
 - (5) screen 6 ft (length) (depth to top)
90 Galvanize (size) (material)
 - (6) pump 3/4 (HP) 4 (yield gpm)
Dectric (type power)
 - (7) electric log no (yes or no)
no (organization running log)
 - (8) how well bottom plugged Rufford




DRILLERS REMARKS:

If well telescopes please sketch and show depths.

GROUND LEVEL

Well

PS

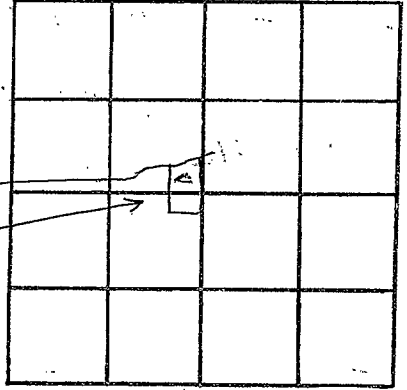

SECTION 22

Please indicate well location X.

ADDITIONAL INFORMATION

If more than one screen, show locations of each on sketch.