


TATE  
E 2009  
2-68

MISSISSIPPI  
BOARD OF WATER COMMISSIONERS  
416 North State Street  
Jackson, Mississippi 39201

WATER WELL DRILLERS LOG


Feb 29 1968 Shelly Keyman Tate  
date well completed firm name county well located

LANDOWNER:	description of formations encountered	from	to
Jerry Reed R. F. D. - 1	Blue clay	0	60
Sarah Miss. (mailing address)	Gravel & Sand	60	70
WELL LOCATION: sec. 25 T. 5 N. R. 10 E. S W	Blue clay	70	170
3 miles S. E. of Savage (distance) (direction) (nearest town)	Solid Rock	170	171
WELL PURPOSE: Home (home, irrigation, municipal, industrial)	Blue clay	171	225
WELL COMPLETION DATA:	Blue Sand	225	230
(1) diameter (inches) 2	Clear Sand	230	238
(2) total depth (feet) 238			
(3) static water level (feet) 65 below top of ground.			
(4) casing Gal 231 (material) (depth)			
(size) if telescope see back.			
(5) screen 6 ft (length) (depth to top)			
90 gauge (size) (material)			
(6) pump 1/4 HP 4 (type power) (yield gpm)			
Electric (type power)			
(7) electric log no (yes or no)			
no (organization running log)			
(8) how well bottom plugged Rubber Seal			
DRILLERS REMARKS:			

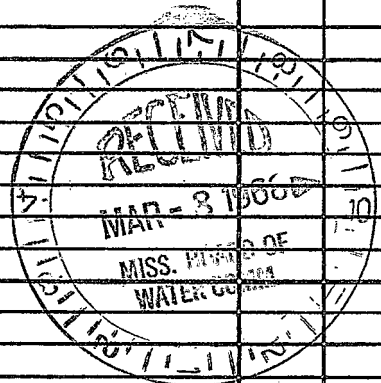

If well telescopes please sketch and show depths.

GROUND LEVEL

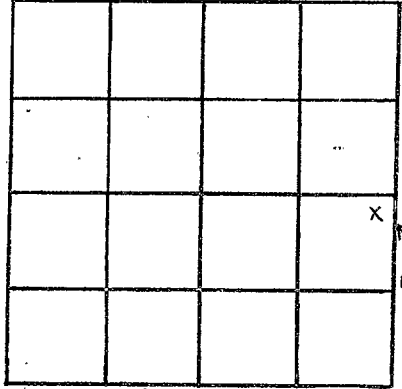

SECTION 25

Please indicate well location X.

ADDITIONAL INFORMATION

If more than one screen, show locations of each on sketch.