

TATE  
E 2010  
2-68

MISSISSIPPI  
BOARD OF WATER COMMISSIONERS  
416 North State Street  
Jackson, Mississippi 39201

WATER WELL DRILLERS LOG

Feb. 17 1968 Shelly Neyman Late  
date well completed firm name county well located


LANDOWNER: Franklin Houston  
Sarah Miss  
R. F. D.  
(mailing address)

Description of formations encountered	from	to
Red clay	0	20
gravel	20	35
Grey clay	35	190
Blue Sand	190	208
White Sand	208	218

WELL LOCATION:  
sec. 20 T. 5 N. R. 9 E. S. W.  
3 miles N of Strayhorn  
(distance) (direction) (nearest town)

WELL PURPOSE: Home  
(home, irrigation, municipal, industrial)

- WELL COMPLETION DATA:
- (1) diameter (inches) 2
  - (2) total depth (feet) 218
  - (3) static water level (feet) 77 below top of ground.
  - (4) casing 2 in Gal. 210 (material) (depth)
  - (size) if telescope see back.
  - (5) screen 6 ft (length) (depth to top)  
90 (size) Gauge (material)
  - (6) pump 3/4 HP (yield gpm).  
Electric (type power)
  - (7) electric log No (yes or no)  
No (organization running log)
  - (8) how well bottom plugged Rubber Seal

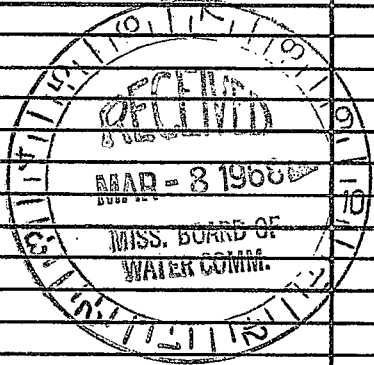

DRILLERS REMARKS:

If well telescopes please sketch and show depths.

GROUND LEVEL

Well



	X		

SECTION 20

Please indicate well location X.

ADDITIONAL INFORMATION

If more than one screen,  
show locations of each on sketch.