

TATE
E 2011
4-68

MISSISSIPPI
BOARD OF WATER COMMISSIONERS
416 North State Street
Jackson, Mississippi 39201

WATER WELL DRILLERS LOG

April 16 1968 Shelby Neyman Tate
date well completed firm name county well located

LANDOWNER:	description of formations encountered	from	to
William C. McLean	Blue clay	0	50
Jonica Nitz (mailing address)	gravel	50	56
	white sand	56	66

WELL LOCATION:
sec. 3 T. 5 N R. 9 E
S W
3 1/2 miles S of Arkabutla
(distance) (direction) (nearest town)

WELL PURPOSE:
(home, irrigation, municipal, industrial)

WELL COMPLETION DATA:

(1) diameter (inches) 2

(2) total depth (feet) 66

(3) static water level (feet) 14 below top of ground.

(4) casing Galvanne 60 (material) (depth)

(size) if telescope see back.

(5) screen 6 ft (length) (depth to top)
1 1/4 (size) Gauge (material)

(6) pump Pitcher (HP) (yield gpm)
Man Power (type power)

(7) electric log No (yes or no)
No (organization running log)

(8) how well bottom plugged Rubber seal


MAY 10 1968

DRILLERS REMARKS:

MISS. BD. OF
VIA

If well telescopes please sketch and show depths.

GROUND LEVEL

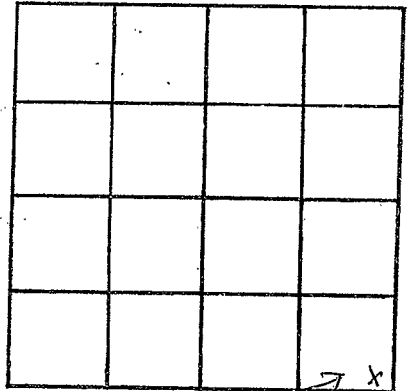

well

SECTION 3

Please indicate well location X.

ADDITIONAL INFORMATION

If more than one screen,
show locations of each on sketch.