

State
E 2013
10-10-75

MISSISSIPPI
 BOARD OF WATER COMMISSIONERS
 416 North State Street
 Jackson, Mississippi 39201

WATER WELL DRILLERS LOG

10-10 1975 Hicks Well Co. State
 date well completed firm name county well located

LANDOWNER: J. E. Swift
3358 Bixdale
Memphis, Tenn.
 (mailing address)

WELL LOCATION:
 sec. 15 T. 9 S. R. 5 E. 15 E
4 miles ES of Abbeville
 (distance) (direction) (nearest town)

description of formations encountered	from	to
<u>Red Clay</u>	<u>0</u>	<u>30</u>
<u>Red Sand</u>	<u>30</u>	<u>45</u>
<u>White Sand + Black Clay</u>	<u>45</u>	<u>60</u>
<u>Black Clay</u>	<u>60</u>	<u>165</u>
<u>Black Clay + white sand</u>	<u>165</u>	<u>180</u>
<u>White Sand</u>	<u>180</u>	<u>200</u>

WELL PURPOSE: same
 (home, irrigation, municipal, industrial)

WELL COMPLETION DATA:

(1) diameter (inches) 4 in.

(2) total depth (feet) 200

(3) static water level (feet) 120 below above top of ground.

(4) casing Plastic, 200,
 (material) (depth)
 (size) If telescope see back.

(5) screen 7 ft, 193
 (length) (depth to top)
4 in., stainless
 (size) (material)

(6) pump 1/2 10
 (HP) (yield gpm)
200
 (type power)

(7) electric log no
 (yes or no)

(organization running log)

(8) how well bottom plugged cap


DRILLERS REMARKS:

NOV 13 1975

MISS. RD. OF WATER COM.

If well telescopes please sketch and show depths.

GROUND LEVEL

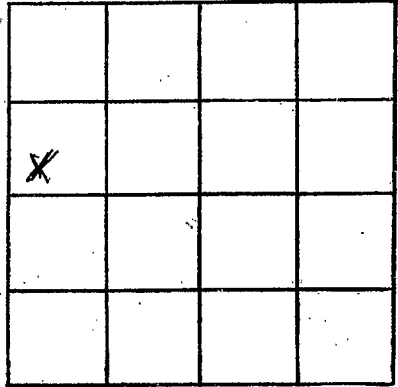

SECTION 15

Please indicate well location X.

ADDITIONAL INFORMATION

If more than one screen, show locations of each on sketch.