

TATE  
E 2015  
5-6-77

MISSISSIPPI  
BOARD OF WATER COMMISSIONERS  
416 North State Street  
Jackson, Mississippi 39201

WATER WELL DRILLERS LOG

5-6 date well completed 1977 Highwell Co. firm name Tate county well located

LANDOWNER: Jodee Taylor  
Senatobia, Ms.  
38668  
(mailing address)

description of formations encountered	from	to
Red Clay	0	40
Black Clay	40	145
White Sand	145	170

WELL LOCATION:

sec 20 T 5 N R 9 E  
3 miles NW of Stratton  
(distance) (direction) (nearest town)

WELL PURPOSE: Home  
(home, irrigation, municipal, industrial)

WELL COMPLETION DATA:


- (1) diameter (inches) 4
- (2) total depth (feet) 170
- (3) static water level (feet) 80 below top of ground.
- (4) casing PVC (material) (depth)
- (size) If telescope see back.
- (5) screen 7' (length) 163 (depth to top)
- 4" gravel type (size) (material)
- (6) pump 1/2 (HP) 10 (yield gpm)
- 220V (type power)
- (7) electric log No (yes or no)
- (organization running log)
- (8) how well bottom plugged. Cap

RECEIVED  
MAY 13 1977  
MISS. BD. OF WATER COMMISSIONERS

DRILLERS REMARKS:

If well telescopes please sketch and show depths.

GROUND LEVEL

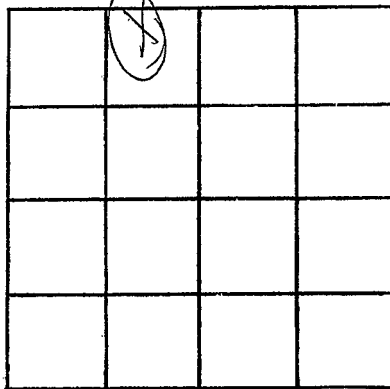

SECTION 20

Please indicate well location X.

ADDITIONAL INFORMATION

Lined area for additional information.

If more than one screen, show locations of each on sketch.