

TATE  
E 204  
6-7-77

MISSISSIPPI  
BOARD OF WATER COMMISSIONERS  
416 North State Street  
Jackson, Mississippi 39201

WATER WELL DRILLERS LOG

15E  
6-7 1977 Dick Well Co. Tate  
date well completed firm name county well located

LANDOWNER: Charles Ross  
Pt. 2  
Senatobia, Mo.  
(mailing address)

WELL LOCATION:  
sec. 26 T-5 N R-9 E  
1 1/2 miles E of Strayhorn  
(distance) (direction) (nearest town)

WELL PURPOSE: Home  
(home, irrigation, municipal, industrial)

- WELL COMPLETION DATA:
- (1) diameter (inches) 4
  - (2) total depth (feet) 145
  - (3) static water level (feet) 40 below top of ground.
  - (4) casing PVC, 145 (material) (depth)  
(size) If telescope see back.
  - (5) screen 7' 138 (length) (depth to top)  
4" gravel type (size) (material)
  - (6) pump 1/2 10 (HP) (yield gpm)  
220V (type power)
  - (7) electric log No (yes or no)

(organization running log)  
(8) how well bottom plugged Cap


DRILLERS REMARKS:

description of formations encountered	from	to
Red Clay	0	40
Black Clay	40	90
White Sand & clay	90	120
White sand	120	145

RECEIVED  
JUL 13 1977  
MISS. BD. OF WATER COMM.

If well telescopes please sketch and show depths.

GROUND LEVEL

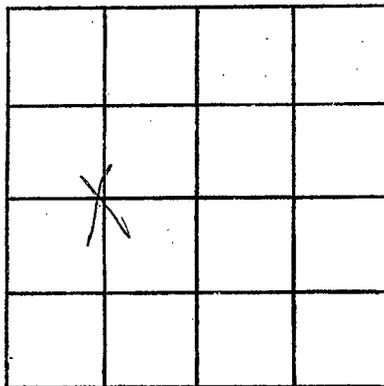

SECTION 26

Please indicate well location X.

ADDITIONAL INFORMATION

If more than one screen,  
show locations of each on sketch.