

TATE
207 E
3/3/78

**MISSISSIPPI
BOARD OF WATER COMMISSIONERS**
416 North State Street
Jackson, Mississippi 39201

WATER WELL DRILLERS LOG

3-3 1978 Heick Well Co. Tate
 date well completed firm name county well located

LANDOWNER: Cecil Cole Jr.
Senatobia, Ms. 38662
 (mailing address)

description of formations encountered	from	to
Red clay	0	30
Red clay + gravel	30	60
Black clay + gravel	60	160
White Sand	160	185

WELL LOCATION:
 sec. 14 T. 5 N. R. 9 E
3 1/2 miles NE of Senatobia
 (distance) (direction) (nearest town)

WELL PURPOSE: Home Parlor
 (home, irrigation, municipal, industrial)

WELL COMPLETION DATA:

(1) diameter (inches) 4

(2) total depth (feet) 185

(3) static water level (feet) 120 below above top of ground.

(4) casing PVC 185
 (material) (depth)

 if telescope see back.
 (size)

(5) screen 7' 178
 (length) (depth to top)

4" PVC + Gravel
 (size) (material)

(6) pump 1/2 10
 (HP) (yield gpm)

220V
 (type power)

(7) electric log No
 (yes or no)

 (organization running log)

(8) how well bottom plugged Cap


DRILLERS REMARKS:

RECEIVED
APR 20 1978

MISS. BD. OF WATER COMM

If well telescopes please
sketch and show depths.

GROUND LEVEL

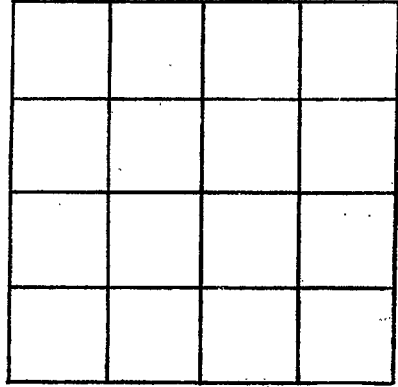

SECTION _____

Please indicate well location X.

ADDITIONAL INFORMATION

If more than one screen,
show locations of each on sketch.