

TATE
 E 2018
 4-17-78

MISSISSIPPI
 BOARD OF WATER COMMISSIONERS
 416 North State Street
 Jackson, Mississippi 39201

WATER WELL DRILLERS LOG

4-17-78 date well completed High Well Co firm name Tate county well located

LANDOWNER: J.C. Scott
 Takabutta
 Coldwater, Ms.
 (mailing address)

description of formations encountered	from	to
Red clay	0	190
Black clay	190	350
White sand	350	400

WELL LOCATION:
 sec. 6 T 9 N R 9 E
 5 miles N of Takabutta
 (distance) (direction) (nearest town)

WELL PURPOSE: Pond
 (home, irrigation, municipal, industrial)

WELL COMPLETION DATA:

(1) diameter (inches) 4

(2) total depth (feet) 400

(3) static water level (feet) 325 below top of ground.

(4) casing PVC 400 (material), (depth)

(size) if telescope see back.

(5) screen 35' 315 (length), (depth to top)

4" gravel type (size), (material)

(6) pump 5 40 (HP), (yield gpm)

220V (type power)

(7) electric log No (yes or no)

(organization running log)

(8) how well bottom plugged Cap


RECEIVED
 MAY 4 - 1978

DRILLERS REMARKS:

MISS. BD. OF WATER COMM

If well telescopes please sketch and show depths.

GROUND LEVEL

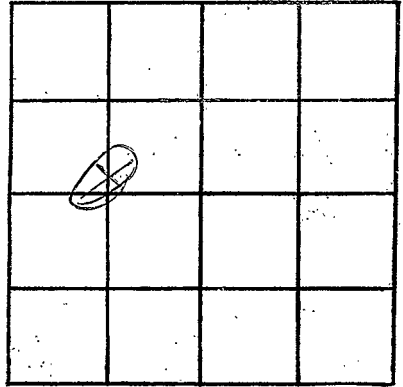

SECTION 6

Please indicate well location X.

ADDITIONAL INFORMATION

If more than one screen,
show locations of each on sketch.