

MISSISSIPPI DEPARTMENT OF NATURAL RESOURCES

Bureau of Land and Water Resources

Southport Mall

P.O. Box 10631

Jackson, Mississippi 39209

WATER WELL DRILLERS LOG

Date
 E 2020
 9-15-80

9-15 1980 date well completed
 Bu Smith firm name
 Tate county well located

LANDOWNER:
 Gray Yates
 Orange, Miss.
 (mailing address)

description of formations encountered	from	to
top soil	0	5
red clay	5	70
sand	70	100

WELL LOCATION:
 sec 23 T 5 N R 10 E
 (S) (W)
 2 miles EAST of Savage
 (distance) (direction) (nearest town)

WELL PURPOSE:
 (home, irrigation, municipal, industrial)

WELL COMPLETION DATA:

(1) diameter (inches) ~~2"~~ 2"
 (2) total depth (feet) 100'
 (3) static water level (feet) 80' below above top of ground.
 (4) casing plastic, 100' (material) (depth)
 (size) if telescope see back.
 (5) screen 20' 90' (length) (depth to top)
 2" plastic (size) (material)
 (6) pump 1/2 10 (HP) (yield gpm)
 elec (type power)
 (7) electric log (yes or no)
 (organization running log)
 (8) how well bottom plugged Cap

DRILLERS REMARKS:


DEPT. OF NATURAL RESOURCES
 BUREAU OF LAND & WATER RESOURCES

SEP 7 1982

RECEIVED

If well telescopes please sketch and show depths.

GROUND LEVEL

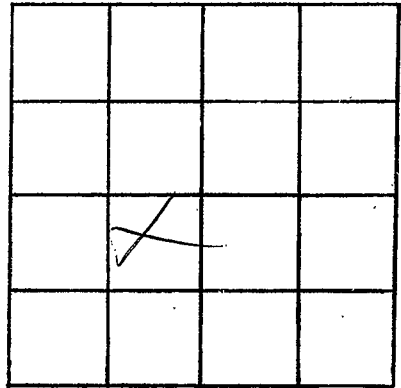

SECTION _____

Please indicate well location X.

ADDITIONAL INFORMATION

If more than one screen,
show locations of each on sketch.