

Tate
E 2021
2-14-80

MISSISSIPPI
BOARD OF WATER COMMISSIONERS
416 North State Street
Jackson, Mississippi 39201

WATER WELL DRILLERS LOG

2-14 date well completed 80 High Well Co firm name Tate county well located

LANDOWNER:
Charles Ross
Rt 2, Lumbardia Miss.
(mailing address)

WELL LOCATION:
sec. 25 T. 6^S R. 9^E
 $\frac{1}{2}$ miles E of Stoughton
(distance) (direction) (nearest town)

WELL PURPOSE: home
(home, irrigation, municipal, industrial)

WELL COMPLETION DATA:
(1) diameter (inches) 4 in
(2) total depth (feet) 145
(3) static water level (feet) 100 below above top of ground.
(4) casing Plastic 145
(material) (depth)
(size) if telescope see back.
(5) screen 7 ft 138
(length) (depth to top)
4 in Gravel
(size) (material)
(6) pump 1/2 10
(HP) (yield gpm)
220
(type power)
(7) electric log No
(yes or no)
(organization running log)
(8) how well bottom plugged Cap

description of formations encountered	from	to
Red Clay	0	30
Black Clay	30	110
White sand	110	145


DEPT. OF NATURAL RESOURCES
BUREAU OF LAND & WATER RESOURCES

MAR 10 1980

RECEIVED

If well telescopes please sketch and show depths.

GROUND LEVEL

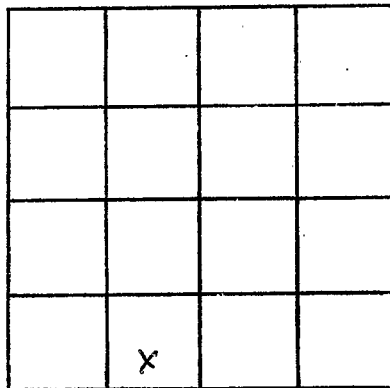

SECTION 25

Please indicate well location X.

ADDITIONAL INFORMATION

Multiple horizontal lines for additional information.