

MISSISSIPPI DEPARTMENT OF NATURAL RESOURCES
 Bureau of Land and Water Resources
 Southport Mall
 P.O. Box 10631
 Jackson, Mississippi 39209
WATER WELL DRILLERS LOG

TATE
E 2022
11-19-80

11-19 1980 Hicks Well Co. Tate
 date well completed firm name county well located

LANDOWNER: <u>James L. Reasley</u> <u>Rt. 2</u>	description of formations encountered	from	to
<u>Senatobia, Ms.</u> (mailing address)	<u>Red clay</u>	<u>0</u>	<u>15</u>
WELL LOCATION: sec. <u>12</u> T. <u>5</u> N. R. <u>9</u> E <u>3</u> miles <u>SE</u> of <u>Arkabutla</u> (distance) (direction) (nearest town)	<u>light clay</u>	<u>15</u>	<u>90</u>
WELL PURPOSE: <u>Home</u> (home, irrigation, municipal, industrial)	<u>white sand</u>	<u>90</u>	<u>185</u>
WELL COMPLETION DATA:			
(1) diameter (inches) <u>4</u>			
(2) total depth (feet) <u>185</u>			
(3) static water level (feet) <u>100</u> below top of ground.			
(4) casing <u>PVC</u> , <u>185</u> (material) (depth)			
_____ if telescope see back. (size)			
(5) screen <u>10</u> , <u>175</u> (length) (depth to top)			
<u>4"</u> , <u>Slotted PVC</u> (size) (material)			
(6) pump <u>1/2</u> , <u>10</u> (HP) (yield gpm)			
<u>220V</u> (type power)			
(7) electric log <u>No</u> (yes or no)			
_____ (organization running log)			
(8) how well bottom plugged <u>Cap</u>			
DRILLERS REMARKS:			


DEPT. OF NATURAL RESOURCES
 BUREAU OF LAND & WATER RESOURCES

DEC - 3 1980

RECEIVED

If well telescopes please sketch and show depths.

GROUND LEVEL

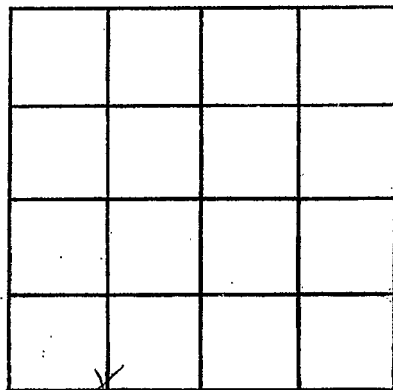

SECTION 12

Please indicate well location X.

ADDITIONAL INFORMATION

If more than one screen,
show locations of each on sketch.