

MISSISSIPPI DEPARTMENT OF NATURAL RESOURCES

Bureau of Land and Water Resources

Southport Mall

P.O. Box 10631

Jackson, Mississippi 39209

WATER WELL DRILLERS LOG

HICKS WELL COMPANY

Date
E 2003
11-2-81

11-2 1981 RT 1 BOX 157
date well completed firm name
TIA MISS county well located

LANDOWNER: Lewis Regis
Rt. 2 Box 50 G
Seventyline, Ms. 38662
(mailing address)

WELL LOCATION:
sec. 15 T 5 N R 9 E
2 miles NE of Strawberry
(distance) (direction) (nearest town)

WELL PURPOSE: Home
(home, irrigation, municipal, industrial)

WELL COMPLETION DATA:

(1) diameter (inches) 4

(2) total depth (feet) 200

(3) static water level (feet) 125 below above
top of ground.

(4) casing PVC 200
(material) (depth)

(size) if telescope see back.

(5) screen 12 188
(length) (depth to top)

4" gravel pack
(size) (material)

(6) pump 3/4 10
(HP) (yield gpm)

220V
(type power)

(7) electric log No
(yes or no)

(organization running log)

(8) how well bottom plugged Cap

description of formations encountered	from	to
Red Clay	0	20
Black Clay	20	150
White Sand	150	200

DRILLERS REMARKS:


DEPT. OF NATURAL RESOURCES
BUREAU OF LAND & WATER RESOURCES

NOV 9 - 1981

RECEIVED

If well telescopes please sketch and show depths.

GROUND LEVEL

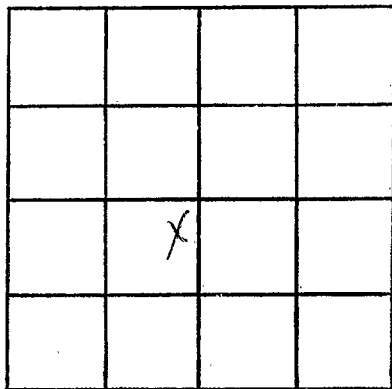

SECTION 15

Please indicate well location X.

ADDITIONAL INFORMATION

If more than one screen,
show locations of each on sketch.