

MISSISSIPPI DEPARTMENT OF NATURAL RESOURCES

Bureau of Land and Water Resources

Southport Mall ¹⁴

P.O. Box 10631

Jackson, Mississippi 39209

WATER WELL DRILLERS LOG

HICKS WELL CO.

Box 157
 Senatobia, MS 38668

Date
E 2025

10-15 1984
 date well completed

Tate
 county well located

LANDOWNER: Carl Willard

description of formations encountered

from

to

Rt. 1
Caldwater, Ms. 38618
 (mailing address)

Red Clay

0

10

Red Sand

10

20

WELL LOCATION:
 sec. 2 T 5 N R. 9 E
1 1/4 miles S of Senatobia
 (distance) (direction) (nearest town)

White Sand

20

30

Black Clay + Gravel

30

150

Black Clay

150

230

WELL PURPOSE: Home
 (home, irrigation, municipal, industrial)

Black Clay + Sand

230

245

WELL COMPLETION DATA:

White Sand

245

260

(1) diameter (inches) 4

(2) total depth (feet) 260

(3) static water level (feet) 90 ^{below} _{above} top of ground.

(4) casing PVC, 260
 (material) (depth)

4"
 (size) if telescope see back.

(5) screen 10', 250'
 (length) (depth to top)

010, PVC
 (size) (material)

(6) pump 3/4, 10
 (HP) (yield gpm)

2200
 (type power)

(7) electric log No
 (yes or no)

(organization running log)

(8) how well bottom plugged Cap

DRILLERS REMARKS:


DEPT. OF NATURAL RESOURCES
 BUREAU OF LAND & WATER RESOURCES

NOV 28 1984

RECEIVED

If well telescopes please sketch and show depths.

GROUND LEVEL

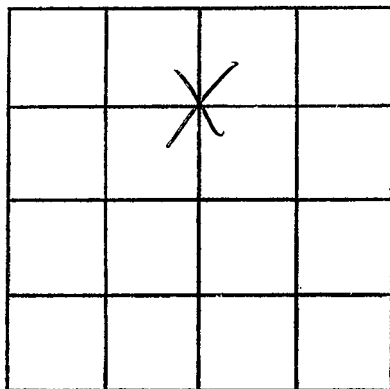

SECTION 2

Please indicate well location X.

ADDITIONAL INFORMATION

If more than one screen,
show locations of each on sketch.