

MISSISSIPPI DEPARTMENT OF NATURAL RESOURCES

Bureau of Land and Water Resources

Southport Mall

P.O. Box 10631

Jackson, Mississippi 39209

WATER WELL DRILLERS LOG

Tate
E 2008

4-10 1986
date well completed

Success Water Well
firm name

Tate
county well located

LANDOWNER: R. J. Barrett
8442 Hwy 301 N
Lake Cormorant, Mo. 38641
(mailing address)

description of formations encountered

from to

8442 Hwy 301 N
Lake Cormorant, Mo. 38641
(mailing address)

Top Soil	0	2
Clay	2	20
Sand-Coal	20	40
Blue gumbo Clay	40	170
White sand	170	200

WELL LOCATION:


sec 29 T 5 N R 9 E
6 miles NW of Staphors
(distance) (direction) (nearest town)

WELL PURPOSE: Home
(home, irrigation, municipal, industrial)

WELL COMPLETION DATA:

- (1) diameter (inches) 4"
- (2) total depth (feet) 200'
- (3) static water level (feet) 120' below above top of ground.
- (4) casing PVC, 190'
(material) (depth)
4" if telescope see back.
(size)
- (5) screen 10', 185'
(length) (depth to top)
4" PVC
(size) (material)
- (6) pump 3/4 10
(HP) (yield gpm)
Elec
(type power)
- (7) electric log NO
(yes or no)

(organization running log)
- (8) how well bottom plugged Gravel

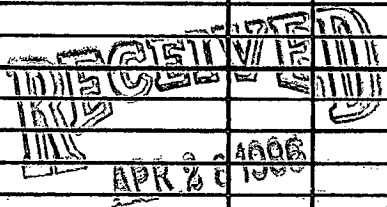


Department of Natural Resources
Bureau of Land & Water

DRILLERS REMARKS:

If well telescopes please sketch and show depths.

GROUND LEVEL

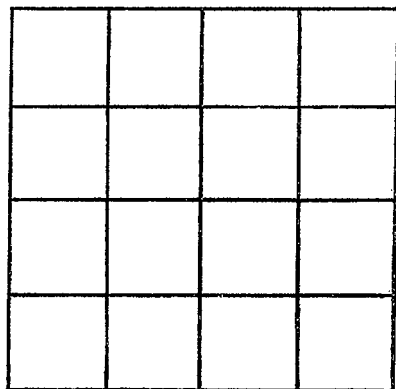

SECTION _____

Please indicate well location X.

ADDITIONAL INFORMATION

If more than one screen, show locations of each on sketch.