

MISSISSIPPI DEPARTMENT OF NATURAL RESOURCES

Bureau of Land and Water Resources

COUNTY WELL LOCATED TATE	
WELL NUMBER E	CODED
DATE WELL COMPLETED 7-31-86	

PERMIT NUMBER
NAME OF DRILLING FIRM Hicks well CO
SENATOBID MS.

P.O. Box 10631
Jackson, Mississippi 39209
WATER WELL DRILLERS LOG

NAME & MAILING ADDRESS OF LANDOWNER Willie Hensley RT 3 Coldwater			
WELL LOCATION: SEC	TOWNSHIP	RANGE	
17	5	N S	9 W
DISTANCE	DIRECTION	NEAREST TOWN	
3 Miles	N	of STRAYHORN	
OTHER LANDMARK			
WELL PURPOSE <input checked="" type="checkbox"/> Home, Irrigation, Municipal, Industrial, Fish Pond, etc.			

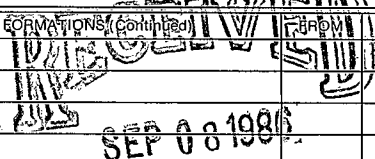
PUMP DATA			
PUMP TYPE (Circle One): <input checked="" type="checkbox"/> Submersible, <input type="checkbox"/> Turbine, <input type="checkbox"/> Jet <input type="checkbox"/> Flowing Well, Other (Describe) _____			
POWER TYPE (Circle One): <input checked="" type="checkbox"/> Electric <input type="checkbox"/> Tractor, <input type="checkbox"/> Diesel, <input type="checkbox"/> Gasoline, <input type="checkbox"/> Butane, Other (Describe) _____			
Pump Capacity (GPM) 10	No. of Stages 7	Setting Depth 60	FT.
PUMP TEST			
Well yielded _____ GPM with			
a drawdown of _____ ft.			
after _____ hours of pumping			

WELL DATA		
Well Depth 180	Casing Diameter (In.) 4"	Casing Length (Ft.) 170
Type of Casing PVC	Hole Depth 180	Depth to Static Water Level 20
TYPE OF COMPLETION: (Circle One or More): <input checked="" type="checkbox"/> Gravel Packed <input type="checkbox"/> Underreamed, <input type="checkbox"/> Telescoped, <input type="checkbox"/> Natural Development, <input type="checkbox"/> Open Hole, <input type="checkbox"/> Other		
Top of Lap Pipe or Reduction in Casing FEET IF TELESCOPED OR MORE THAN ONE SCREEN: USE BACK PAGE		

LOG DATA	
TYPE OF LOG RUN (Circle One): <input type="checkbox"/> No Log Run, <input type="checkbox"/> Electric, <input type="checkbox"/> Gamma Ray, <input type="checkbox"/> Density, <input type="checkbox"/> Sonic, <input type="checkbox"/> Neutron, Other (Describe) _____	
Name of Organization Running Log	

SCREEN DATA		
Diameter - Inches 4"	Length - Feet 10	Slot Size - Inches 013
Screen Type PVC slotted	Depth to Bottom - Feet 10	

GEOLOGIC DATA (Office Use Only)			
Surface Elev.	Geologic Unit	Unit Thickness	Depth to Top
Subs. SWL	Date	Analysis	Aquifer Test
Driller's Remarks			

DESCRIPTION OF FORMATIONS ENCOUNTERED	FROM	TO	FORMATIONS (continued)
RC	0	30	 SEP 08 1986
RC - S.	30	45	
GRAVEL	45	53	
B.C	53	138	
WS.	138	180	

Department of Natural Resources
Bureau of Land & Water Resources

IF MORE SPACE IS NEEDED, USE BACK

If well telescopes please sketch and show depths.

GROUND LEVEL

			X

SECTION _____

Please indicate well location X.

ADDITIONAL INFORMATION

If more than one screen,
show location of each on sketch.