

MISSISSIPPI DEPARTMENT OF NATURAL RESOURCES

Bureau of Land and Water Resources

P.O. Box 10631
Jackson, Mississippi 39209
WATER WELL DRILLERS LOG

COUNTY WELL LOCATED <i>Jato</i>		PERMIT NUMBER
WELL NUMBER E	CODED	NAME OF DRILLING FIRM <i>Bullott Water</i>
DATE WELL COMPLETED <i>2031</i> 8-15-87		<i>Well</i>

NAME & MAILING ADDRESS OF LANDOWNER <i>Danny Mc Kinzie</i> <i>Rt 2 Box 50M</i> <i>Senatobia, Mo. 38668</i>		
WELL LOCATION: SEC	TOWNSHIP	RANGE
<i>20</i>	<i>5 N</i>	<i>9 E</i>
DISTANCE	DIRECTION	NEAREST TOWN
<i>10</i> Miles	<i>West</i> of	<i>Senatobia</i>
OTHER LANDMARK		
WELL PURPOSE: <input checked="" type="checkbox"/> Home Irrigation, Municipal, Industrial, Fish Pond, etc.		

PUMP DATA		
PUMP TYPE (Circle One): <input checked="" type="checkbox"/> Submersible, Turbine, Jet, Flowing Well, Other (Describe) _____		
POWER TYPE (Circle One): <input checked="" type="checkbox"/> Electric, Tractor, Diesel, Gasoline, Butane, Other (Describe) _____		
Pump Capacity (GPM)	No. of Stages	Setting Depth
<i>18</i>	<i>12</i>	<i>200</i> FT.
PUMP TEST		
Well yielded <i>18</i> GPM with a drawdown of _____ ft. after _____ hours of pumping		

WELL DATA		
Well Depth <i>230'</i>	Casing Diameter (In.) <i>4"</i>	Casing Length (Ft.) <i>220'</i>
Type of Casing <i>PVC</i>	Hole Depth <i>230'</i>	Depth to Static Water Level <i>140'</i>
TYPE OF COMPLETION: (Circle One or More): Gravel Packed, Underreamed, Telescoped, <input checked="" type="checkbox"/> Natural Development, Open Hole, Other (Describe) _____		
Top of Lap Pipe or Reduction in Casing		
FEET IF TELESCOPED OR MORE THAN ONE SCREEN: USE BACK PAGE		

LOG DATA	
TYPE OF LOG RUN (Circle One): <input checked="" type="checkbox"/> No Log Run, Electric, Gamma Ray, Density, Sonic, Neutron, Other (Describe) _____	
Name of Organization Running Log	

SCREEN DATA		
Diameter - Inches <i>4"</i>	Length - Feet <i>10'</i>	Slot Size - Inches <i>#13</i>
Screen Type <i>PVC</i>	Depth to Bottom - Feet <i>230'</i>	

GEOLOGIC DATA (Office Use Only)			
Surface Elev.	Geologic Unit	Unit Thickness	Depth to Top
Subs. SWL	Date	Analysis	Aquifer Test

Driller's Remarks


RECEIVED

DESCRIPTION OF FORMATIONS ENCOUNTERED	FROM	TO	FORMATIONS (Continued)
<i>top soil</i>	<i>0</i>	<i>2</i>	<div style="font-size: 2em; font-weight: bold; opacity: 0.5;">RECEIVED</div> <div style="font-size: 1.5em; font-weight: bold;">DEC 10 1987</div> <div style="font-weight: bold; margin-top: 10px;">Department of Natural Resources Bureau of Land & Water Resources</div>
<i>red clay</i>	<i>2</i>	<i>30</i>	
<i>glaucon sand</i>	<i>38</i>	<i>60</i>	
<i>blue clay</i>	<i>60</i>	<i>160</i>	
<i>white sand</i>	<i>160</i>	<i>220</i>	

IF MORE SPACE IS NEEDED, USE BACK

If well telescopes please
sketch and show depths.

GROUND LEVEL

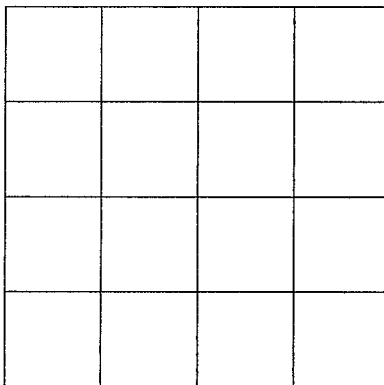

SECTION _____

Please indicate well location X.

ADDITIONAL INFORMATION

If more than one screen,
show location of each on sketch.